


End Bar Detail: Abutment 1
 (Reference Dimension Fabricators Drawing C
 for Bar Size, Type, and Schedule)

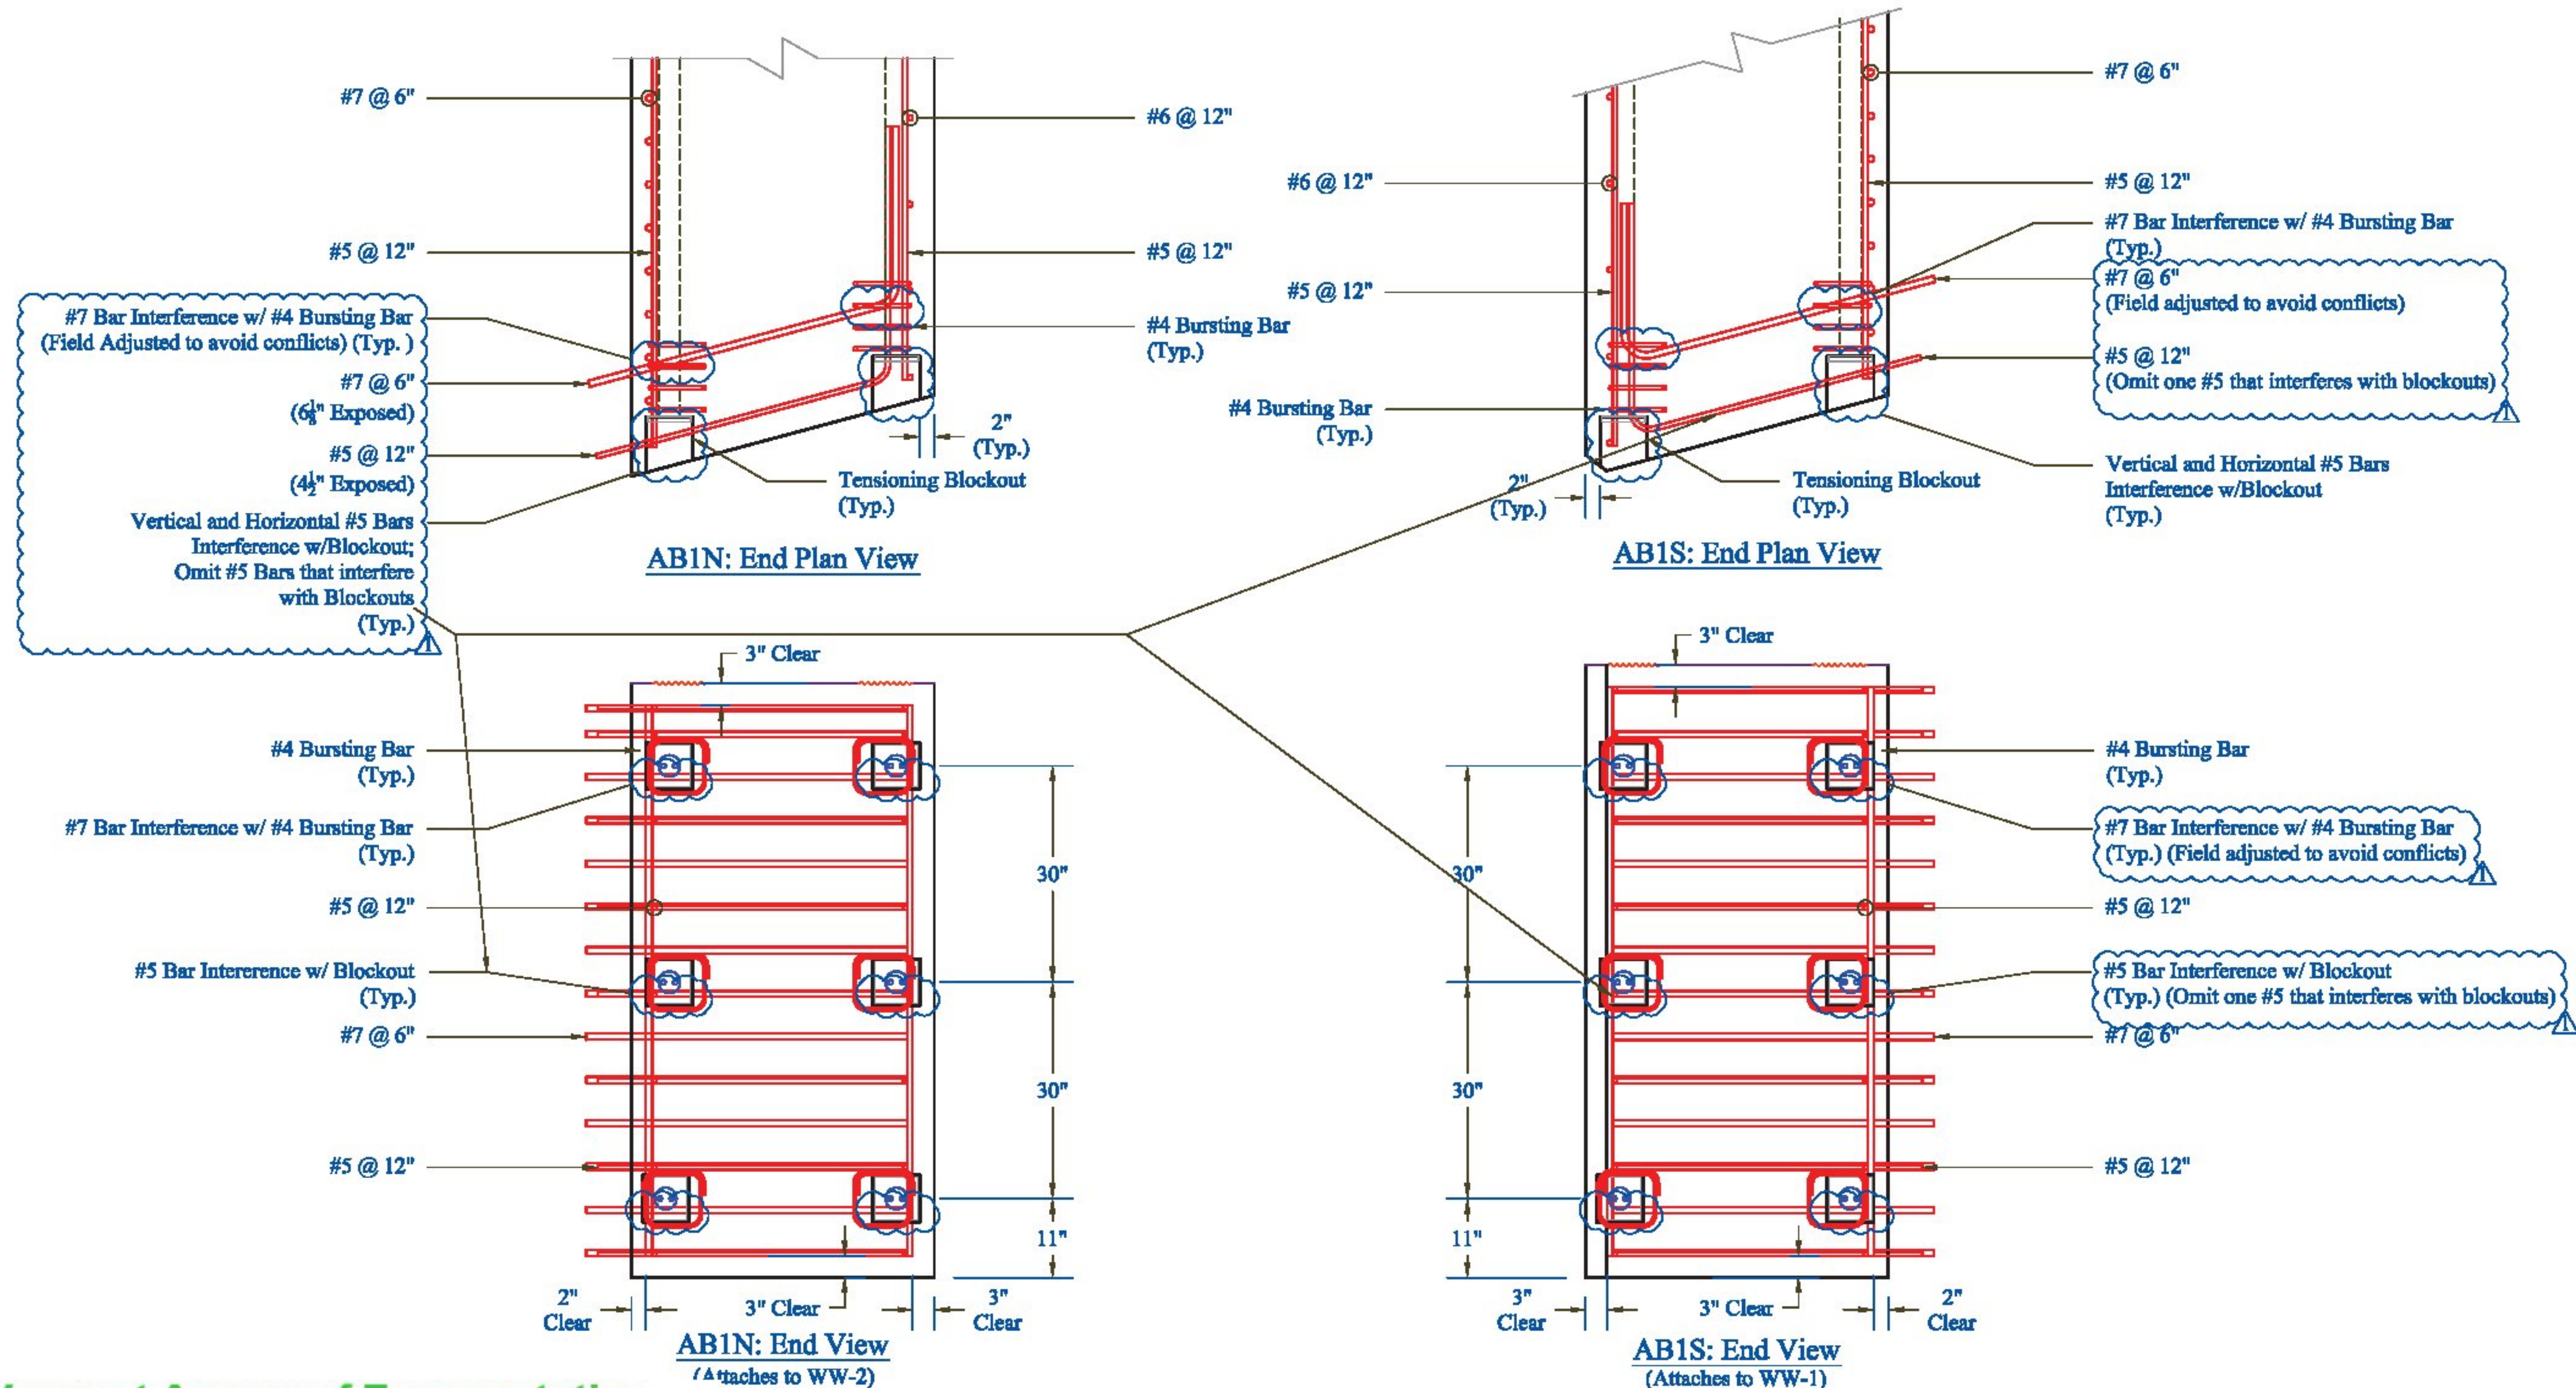

Vermont Agency of Transportation

RECEIVED

CK'D BY CLB OK'D BY DRP

January 13, 2015

RESUBMIT NO Approved
 BY C. CARLSON DATE 01/15/15

:W	PRECAST CONCRETE ABUTMENT SHOP DRAWINGS (SDI JOB #15163)		INSTALLER: CCS Construction 138 Munson Ave Morrisville, VT 05661 PH: 802-888-7701	FABRICATOR: 193 INDUSTRIAL AVE. WILLISTON, VT 05495 PH: (802) 658-0201
	SUPERVISOR: M. WHEELER	PROJECT NAME: Stowe BR# 0235 (II)		
	DETAILER: I. ADAMS	PROJECT # 0235 (II)		
	CHECKER: E. Barendse	LOCATION: Stowe, VT		
ENGINEER:	01/08/15	End Bar Detail Abmt.1	10 of 11	