


End Bar Detail: Abutment 2
 (Reference Dimension Fabricators Drawing D
 for Bar Size, Type, and Schedule)

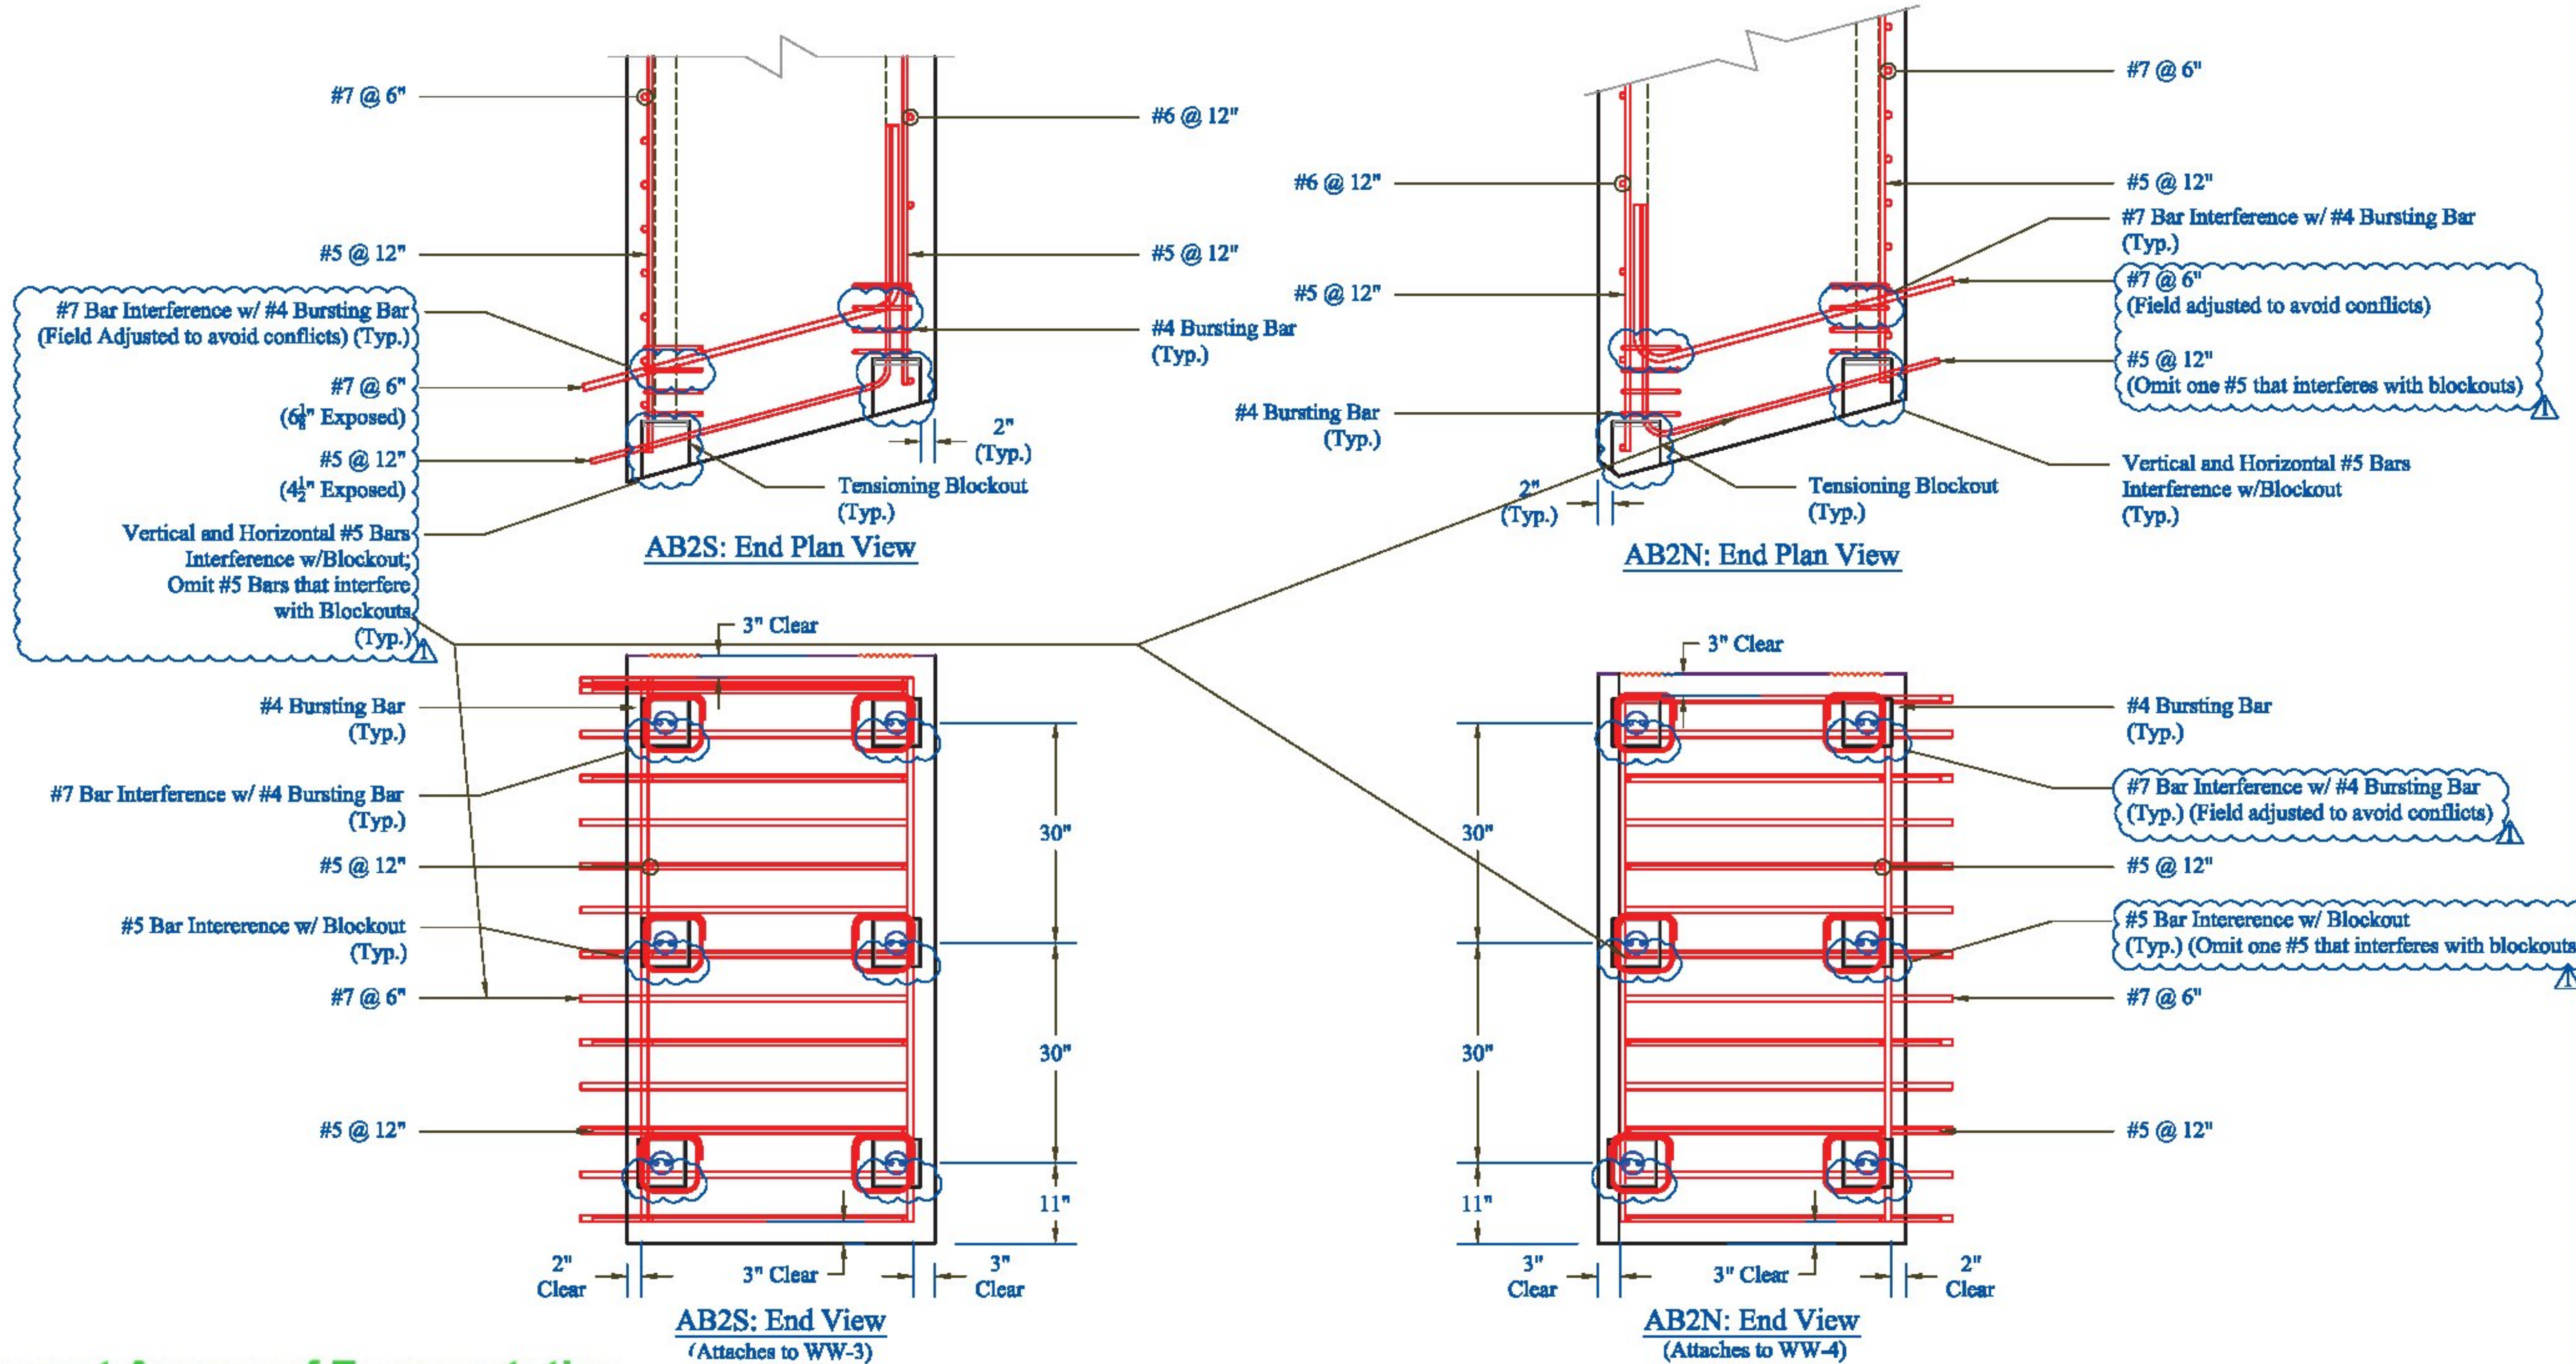

Vermont Agency of Transportation

RECEIVED

CK'D BY CLB OK'D BY DRP

January 13, 2015

RESUBMIT NO Approved
 BY C. CARLSON DATE 01/15/15

N	PRECAST CONCRETE ABUTMENT SHOP DRAWINGS (SDI JOB #15163)		INSTALLER: CCS Construction 138 Munson Ave Morrisville, VT 05661 Ph: 802-888-7701	FABRICATOR: 193 INDUSTRIAL AVE. WILLISTON, VT 05495 Ph: (802) 658-0201
	SUPERVISOR: M. WHEELER DETAILER: I. ADAMS CHECKER: E. Barendse ENGINEER:	PROJECT NAME: Stowe BR# 0235 (II) PROJECT #: 0235 (II) LOCATION: Stowe, VT	01/08/15	End Bar Detail Abmt.2

