

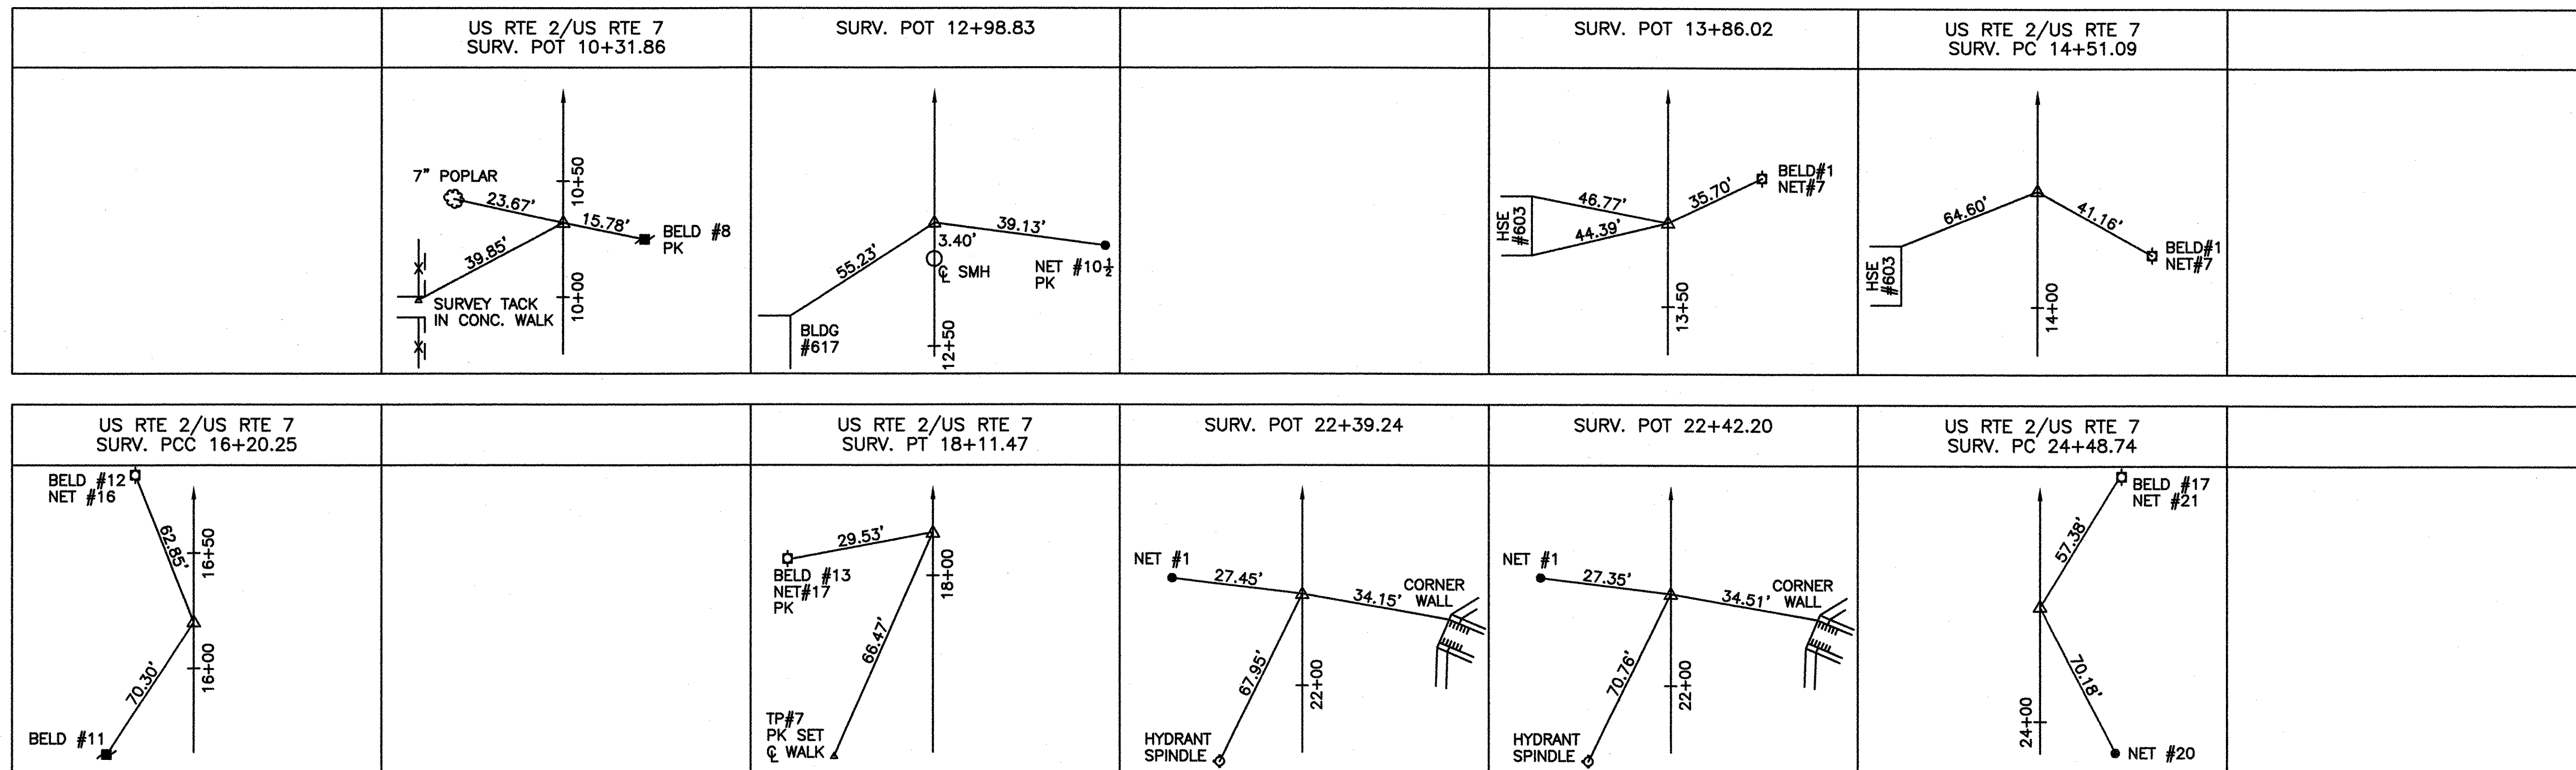


SURVEY LINE TIES

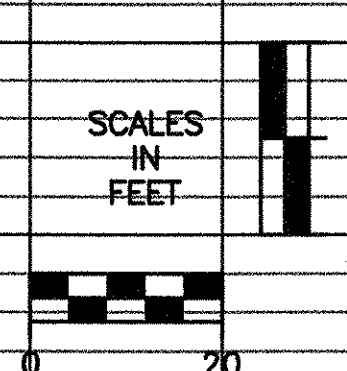

NOT TO SCALE

DATUM
 VERTICAL NGVD 1929
 HORIZONTAL N/A

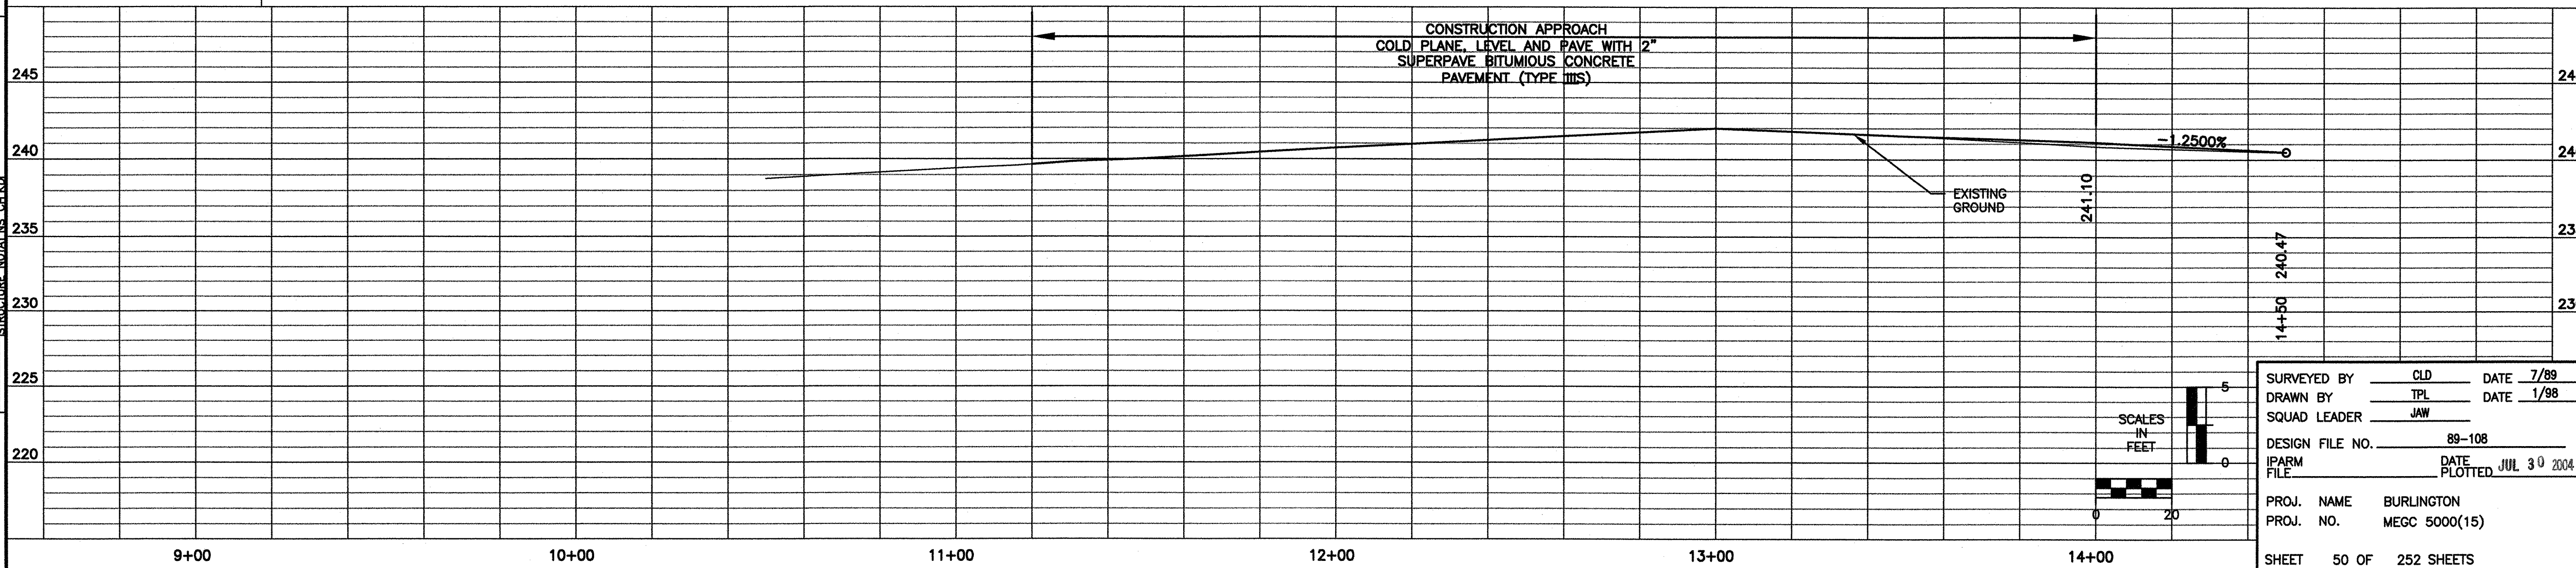

SURVEYED BY CLD DATE 7/89
 DRAWN BY TPL DATE 1/98
 SQUAD LEADER JAW
 DESIGN FILE NO. 89-108
 IPARM FILE DATE PLOTTED JUL 30 2004
 PROJ. NAME BURLINGTON
 PROJ. NO. MEGC 5000(15)
 SHEET 50 OF 252 SHEETS

PLAN
 SURVEYED
 PLOTTED
 ALIGNMENT CHECKED
 RT. OF WAY CHECKED
 NO.

PROFILE
 SURVEYED
 PLOTTED
 GRADES CHECKED
 E.M.'S NOTED
 STRUCTURE NOTATIONS CHECKED

BY _____ DATE _____