


CAST-IN-PLACE CEMENT CONCRETE CURB, TYPE B  
 REMOVAL OF EXISTING FENCE  
 RELOCATE WATER SHUT-OFF (BY OTHERS)

CONSTRUCT DRIVE  
 CHAIN-LINK FENCE, 6 FEET (GALVANIZED)  
 BRACING ASSEMBLY FOR CHAIN-LINK FENCE, 6 FEET

ADJUST ELEVATION OF VALVE BOX  
 SURV. STA 15+90.90 =  
 SURV. STA 15+90.12  
 AHEAD ANGLE = 3'30"12"

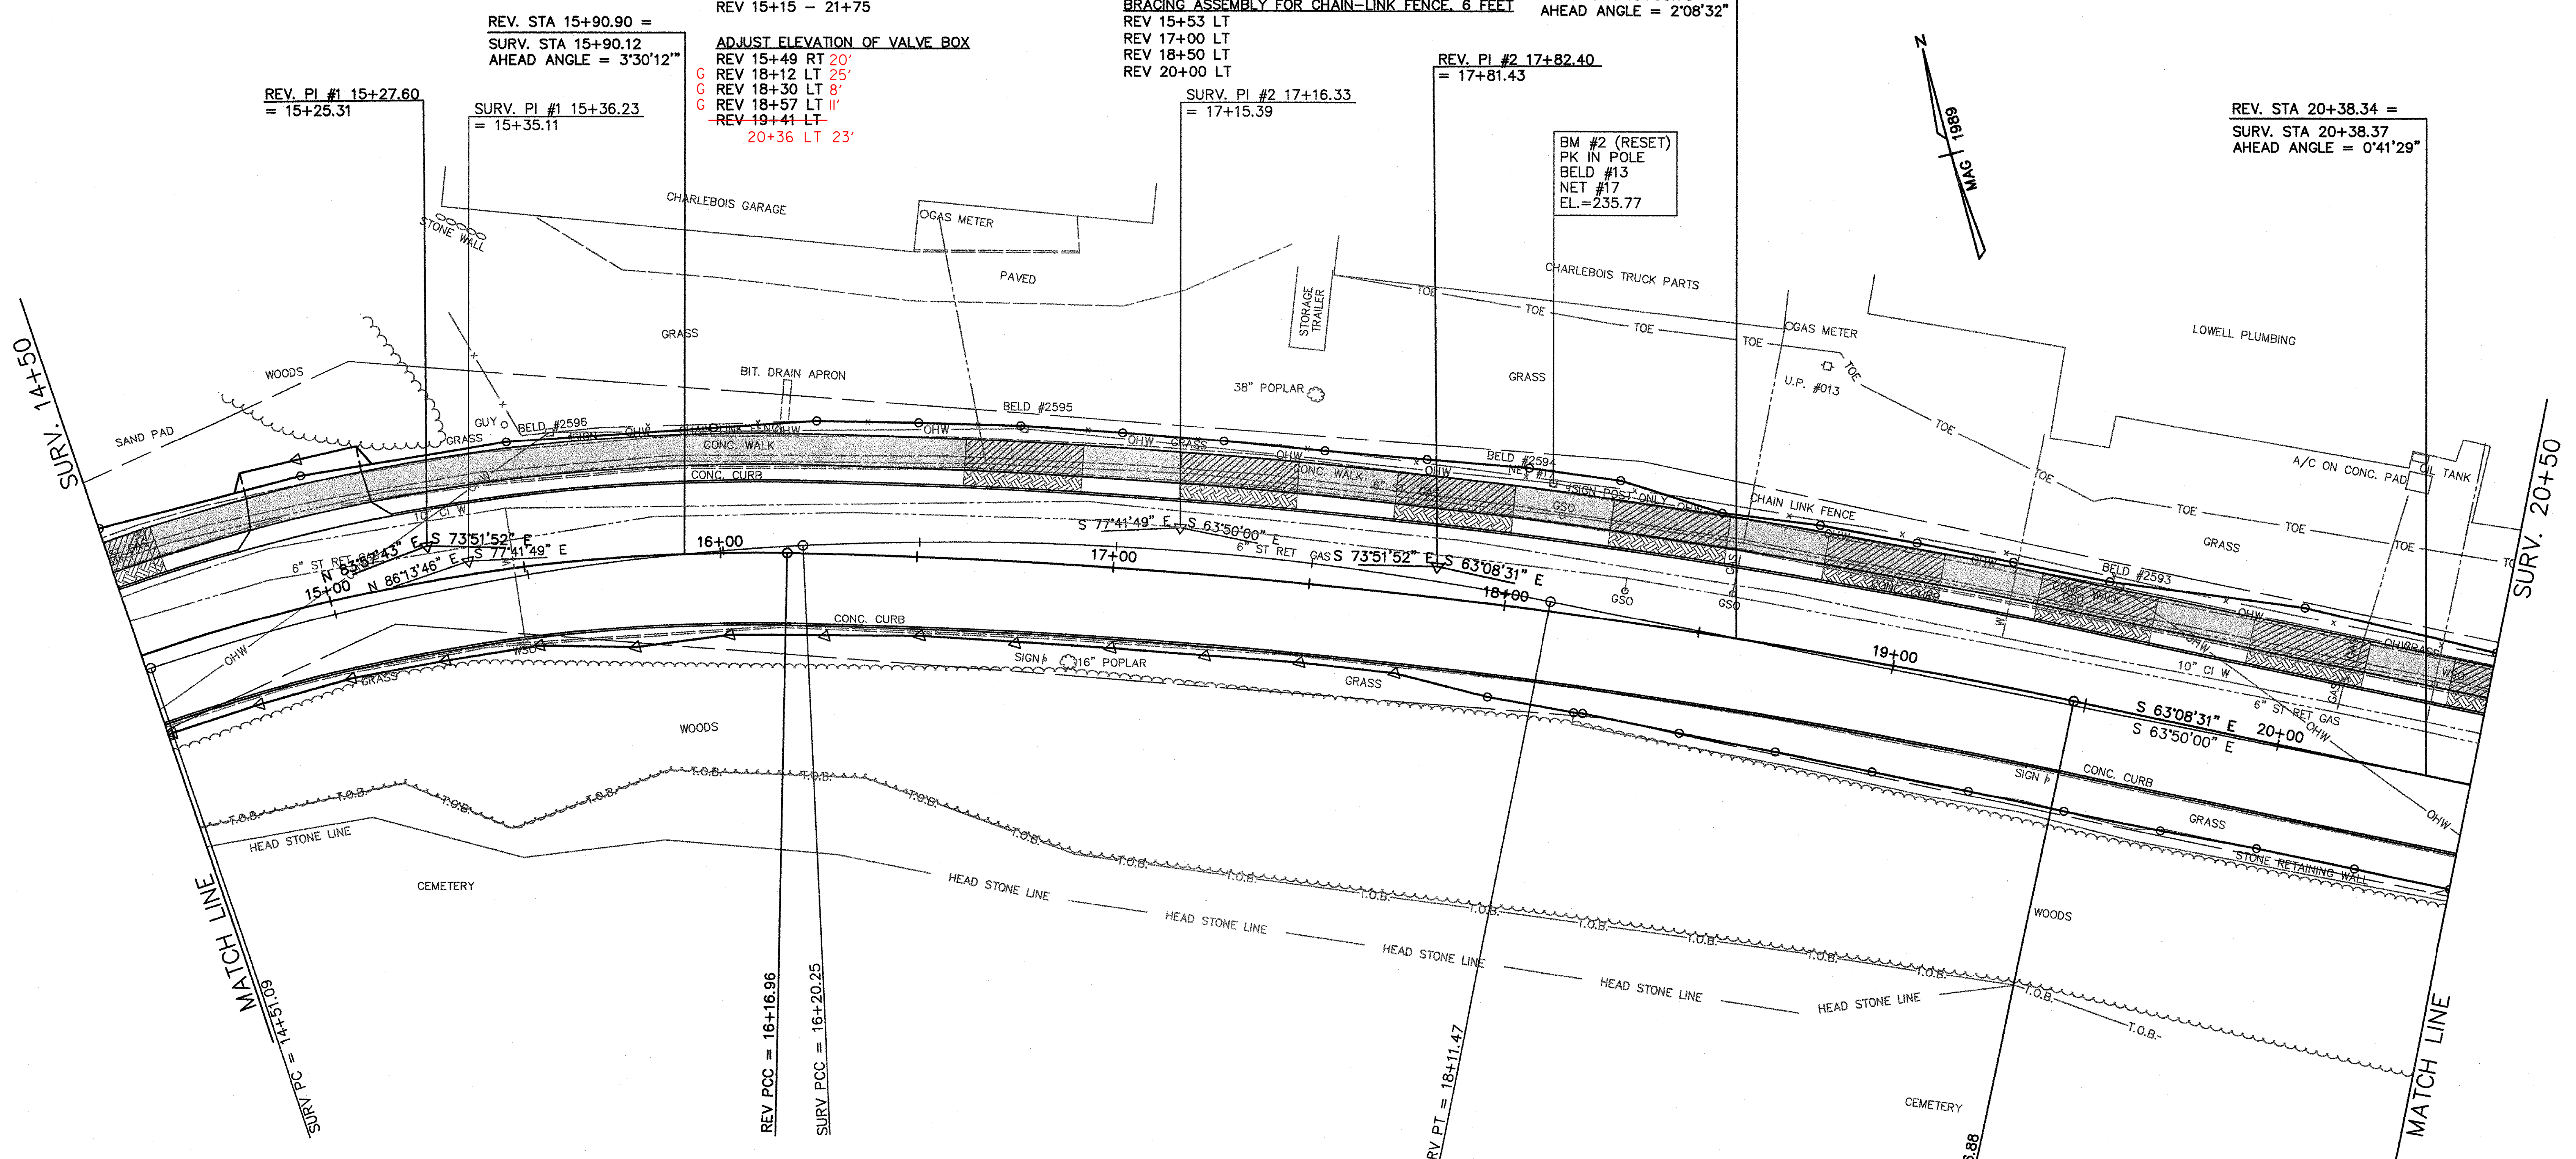

REV. PI #1 15+27.60 = 15+25.31  
 SURV. PI #1 15+36.23 = 15+35.11

SURV. PI #2 17+16.33 = 17+15.39

REV. PI #2 17+82.40 = 17+81.43

REV. STA 20+38.34 =  
 SURV. STA 20+38.37  
 AHEAD ANGLE = 0'41"29"

BM #2 (RESET)  
 PK IN POLE  
 BELD #13  
 NET #17  
 EL.=235.77

REV. CURVE DATA #1

|      |               |
|------|---------------|
| Δ    | = 22'10"24"RT |
| D    | = 12'15"00"   |
| R    | = 467.72      |
| T    | = 91.65       |
| L    | = 181.01      |
| E    | = 8.89        |
| BANK | = N/A         |

SURV. CURVE DATA #1

|      |               |
|------|---------------|
| Δ    | = 16'04"25"RT |
| D    | = 9'30"06"    |
| R    | = 603.00      |
| T    | = 85.14       |
| L    | = 169.16      |
| E    | = 5.98        |
| BANK | = N/A         |

SURV. CURVE DATA #2

|      |               |
|------|---------------|
| Δ    | = 13'51"49"RT |
| D    | = 7'15"00"    |
| R    | = 790.29      |
| T    | = 96.08       |
| L    | = 191.22      |
| E    | = 5.82        |
| BANK | = N/A         |


REV. CURVE DATA #2

|      |               |
|------|---------------|
| Δ    | = 10'43"21"RT |
| D    | = 03'15"00"   |
| R    | = 1762.95     |
| T    | = 165.45      |
| L    | = 329.93      |
| E    | = 7.75        |
| BANK | = N/A         |

STRUCTURAL SOIL  
 TOPSOIL

GENERAL CONSTRUCTION PLAN

|                 |               |               |             |
|-----------------|---------------|---------------|-------------|
| SURVEYED BY     | CLD           | DATE          | 7/89        |
| DRAWN BY        | TUS           | DATE          | 10/93       |
| SQUAD LEADER    | JAW           |               |             |
| DESIGN FILE NO. | 89-108        |               |             |
| IPARM FILE      |               | DATE PLOTTED  | JUL 30 2004 |
| PROJECT NAME:   | BURLINGTON    |               |             |
| PROJECT NUMBER: | MEGC 5000(15) |               |             |
| SHEET           | 51            | OF 252 SHEETS |             |

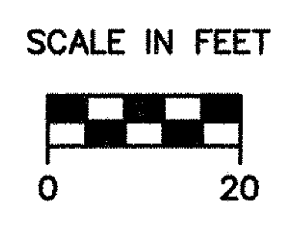

VIEW: CS2  
 DATUM  
 VERTICAL NGVD 1929  
 HORIZONTAL N/A