
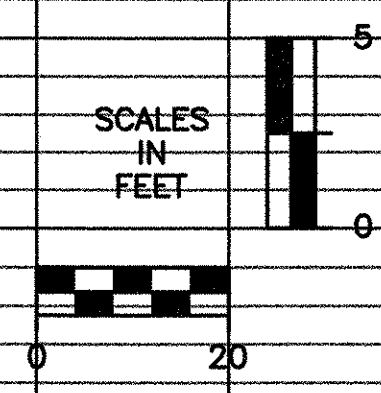


PLAN	SURVEYED	BY	DATE
	PLOTTED		
	ALIGNMENT CHECKED		
	RT. OF WAY CHECKED		
	NO.		

PROFILE	SURVEYED	BY	DATE
	PLOTTED		
	GRADES CHECKED		
	E.M.'S. NOTED		
	STRUCTURE NOTATIONS CHECKED		
	NO.		

DATUM
 VERTICAL NGVD 1929
 HORIZONTAL N/A

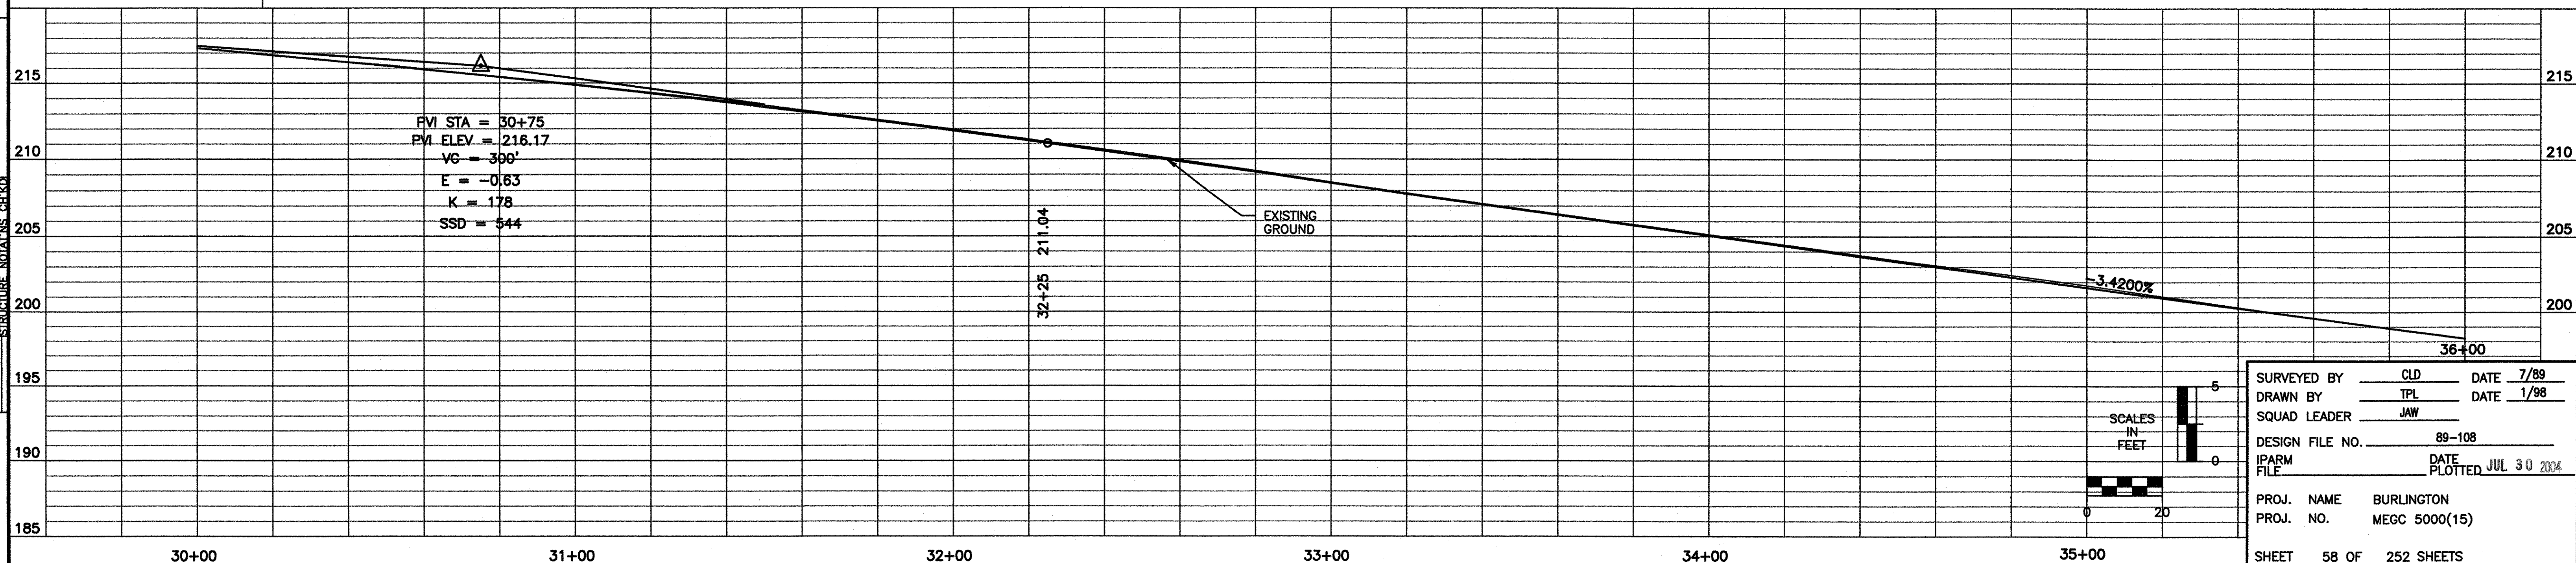

SURVEYED BY	CLD	DATE	7/89
DRAWN BY	TPL	DATE	1/98
SQUAD LEADER	JAW		
DESIGN FILE NO.	89-108		
IPARM FILE		DATE PLOTTED	JUL 30 2004
PROJ. NAME	BURLINGTON		
PROJ. NO.	MEGC 5000(15)		
SHEET	58 OF	252 SHEETS	