


PLAN	REVISED	BY	DATE
NOTE BOOK	ALIGNMENT CHECKED		
NO.	RT. OF WAY CHECKED		

PROFILE	REVISED	BY	DATE
NOTE BOOK	GRADES CHECKED		
NO.	E.M. & NOTED		
	STRUCTURE NOTATIONS CHECKED		

DATUM
 VERTICAL NGVD 1929
 HORIZONTAL N/A

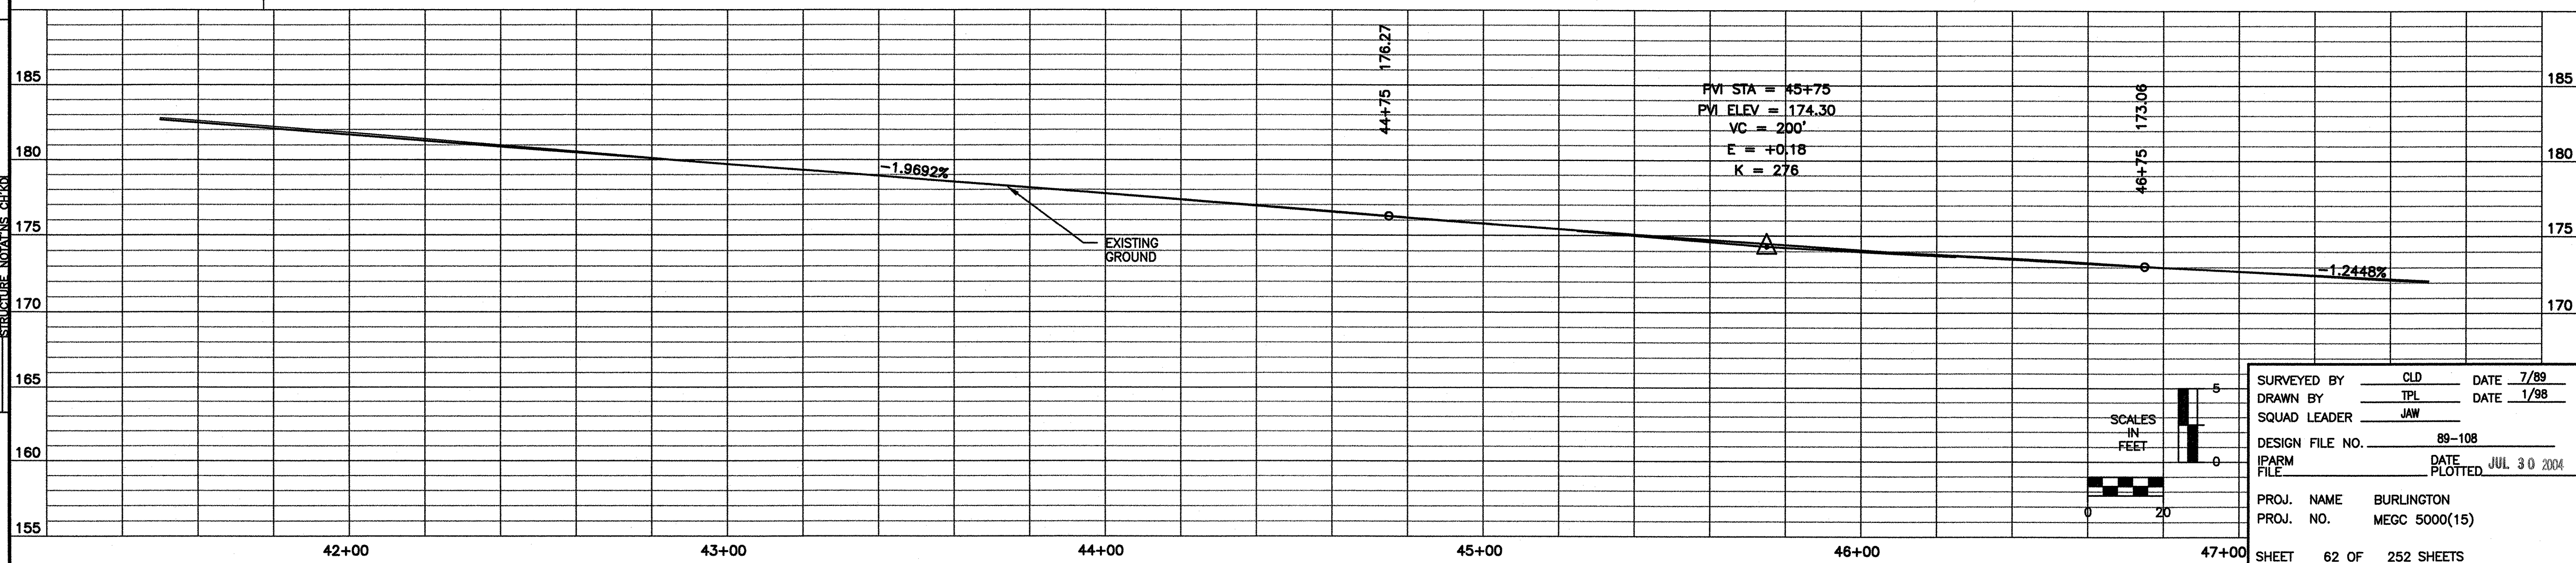

SURVEYED BY	CLD	DATE	7/89
DRAWN BY	TPL	DATE	1/98
SQUAD LEADER	JAW		
DESIGN FILE NO.	89-108		
IPARM FILE		DATE PLOTTED	JUL 30 2004
PROJ. NAME	BURLINGTON		
PROJ. NO.	MEGC 5000(15)		
SHEET	62 OF	252 SHEETS	