
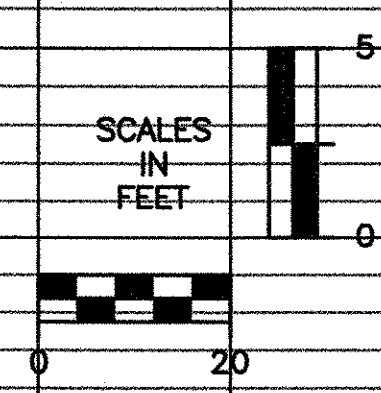


PLAN	BY	DATE
NO.		
NOTE BOOK		
NO.		
ALIGNED		
RT. OF WAY		
CHECKED		

PROFILE	BY	DATE
NO.		
NOTE BOOK		
NO.		
GRADES		
CHECKED		
E.M. & NOTED		
STRUCTURE		
NOTATIONS		
CHECK		

DATUM
 VERTICAL NGVD 1929
 HORIZONTAL N/A

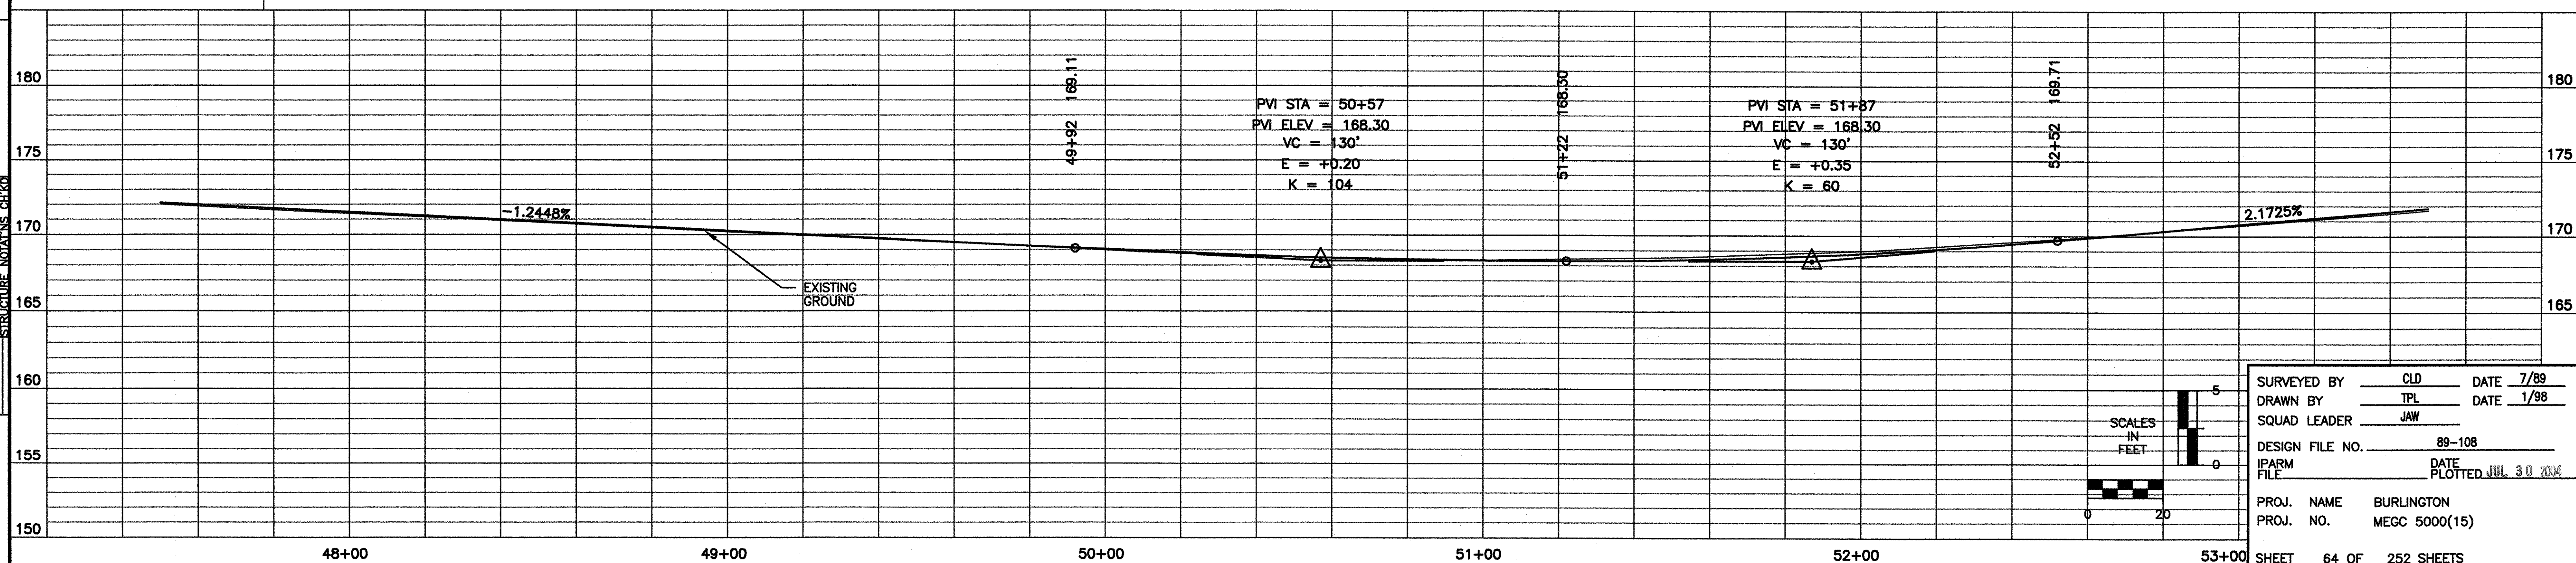

SURVEYED BY	CLD	DATE	7/89
DRAWN BY	TPL	DATE	1/98
SQUAD LEADER	JAW		
DESIGN FILE NO.	89-108		
IPARM FILE		DATE PLOTTED	JUL 30 2004
PROJ. NAME	BURLINGTON		
PROJ. NO.	MEGC 5000(15)		
SHEET	64 OF	252 SHEETS	