


**SOIL INFORMATION**  
 HIE: HARTLAND VERY FINE SANDY LOAM, 25-60% SLOPES  
 HYDRIC SOIL GROUP B  
 DEPTH TO BED ROCK: 60'  
 DEPTH TO WATER TABLE: 6'  
 HIGHLY ERODIBLE LAND  
 K FACTOR = 0.49

49+23 11" RT (7' DEEP)  
 8" VT SEWER  
 (NOT ABANDONED)

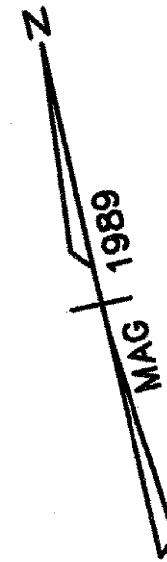

VT-CH-129  
 ARCHAEOLOGICAL SITE  
 DO NOT DISTURB

VT-CH-128  
 ARCHAEOLOGICAL SITE  
 DO NOT DISTURB

SOILS CLASSIFICATION BOUNDARY

SOILS CLASSIFICATION BOUNDARY


**SOIL INFORMATION**  
 Fu: FILL LAND  
 HYDRIC SOIL GROUP (NOT RATED)  
 DEPTH TO BED ROCK: 60'  
 DEPTH TO WATER TABLE: 6'  
 ERODIBILITY (NOT RATED)  
 K FACTOR = N/A

**NOTES:**

1. REFER TO THE CROSS SECTIONS FOR THE GRADE OF THE EXISTING AND PROPOSED CONDITIONS.
2. SOIL PROPERTIES AND BOUNDARIES WERE APPROXIMATED BASED ON USDA SOIL SURVEY. ACTUAL FIELD SURVEY MAY VARY.

**EXISTING CONDITIONS SITE PLAN 8**

SURVEYED BY	CLD	DATE	7/89
DRAWN BY	TJS	DATE	10/93
SQUAD LEADER	JAW		
DESIGN FILE NO.	89-108		
IPARM FILE		DATE PLOTTED	JUL 30 2004
PROJECT NAME:	BURLINGTON		
PROJECT NUMBER:	MEGC 5000(15)		
SHEET 71L OF 252 SHEETS			

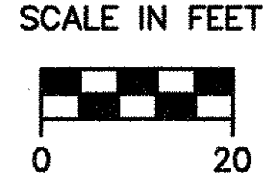

VIEW: CSB

<b>DATUM</b>	
VERTICAL	NGVD 1929
HORIZONTAL	N/A

