


THE FINAL CONDITIONS SITE PLANS REFLECT THE FINISHED PRODUCT. ALL DISTURBED AREAS OUTSIDE OF THE ROADWAY, DRIVES, SIDEWALK, AND LANDSCAPED AREAS WILL BE SEEDED AND MULCHED.

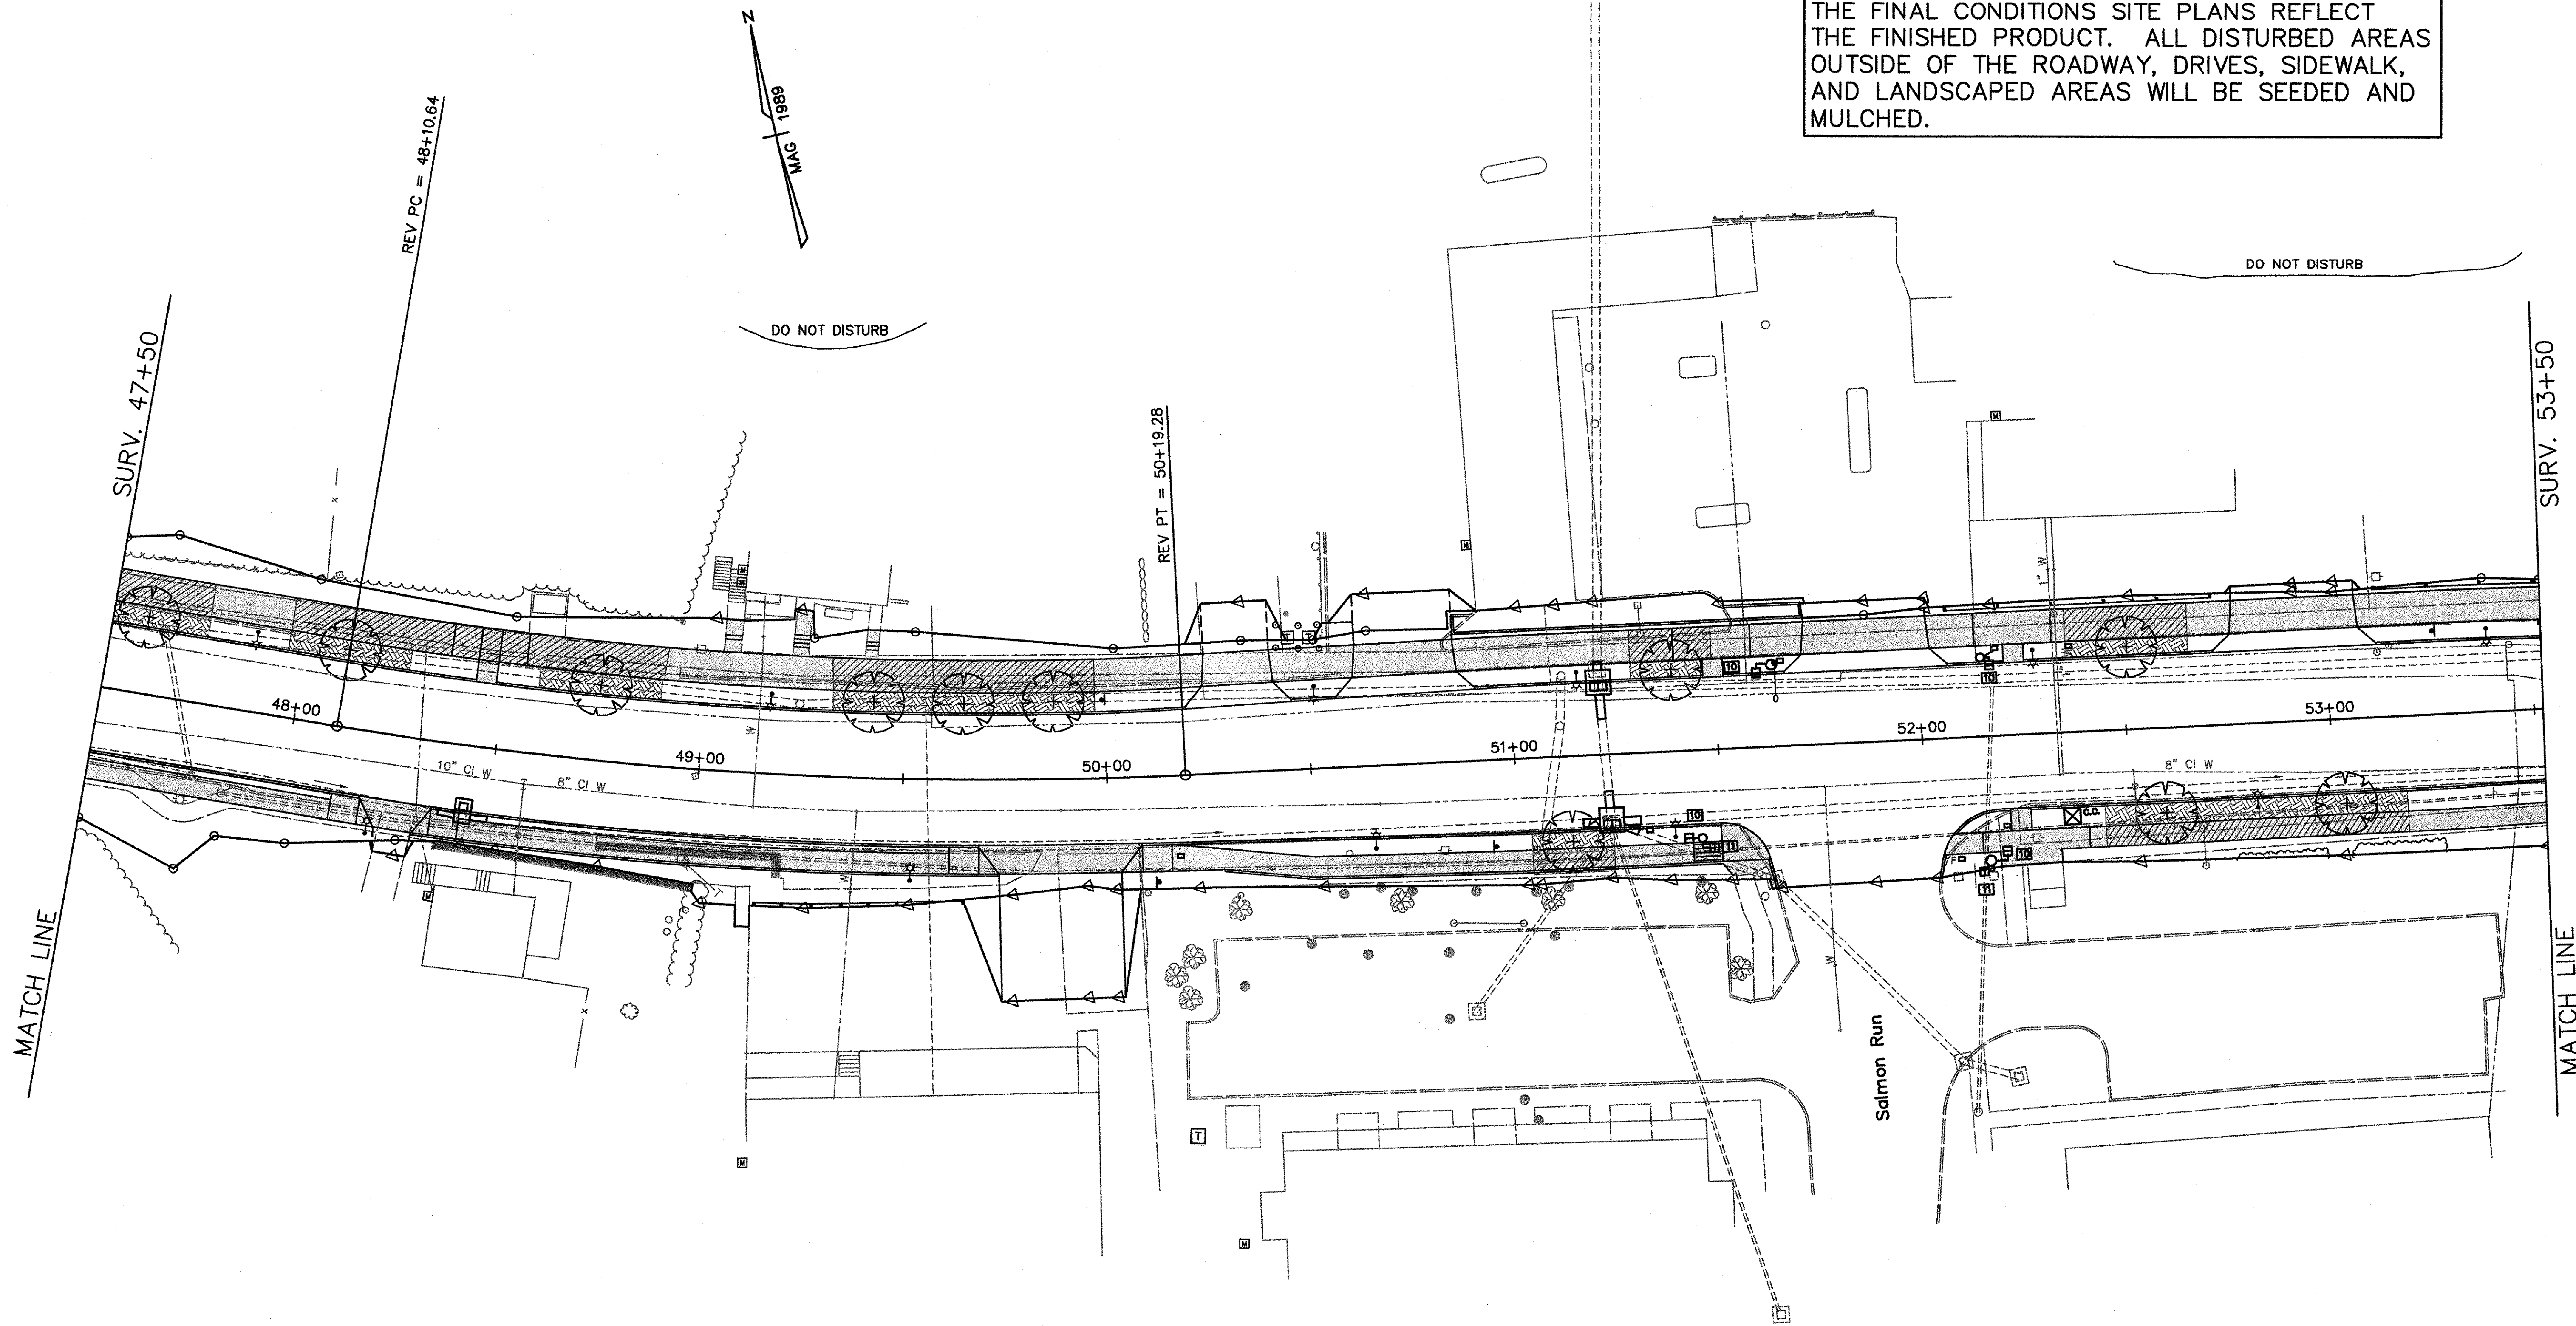

NOTES:

1. REFER TO THE CROSS SECTIONS FOR THE GRADE OF THE EXISTING AND PROPOSED CONDITIONS.

**FINAL CONDITIONS
SITE PLAN 8**

SURVEYED BY CLD DATE 7/89
 DRAWN BY TUS DATE 10/93
 SQUAD LEADER JAW
 DESIGN FILE NO. 89-108
 IPARM FILE DATE PLOTTED JUN 30 2004


PROJECT NAME: BURLINGTON
 PROJECT NUMBER: MEGC 5000(15)

SHEET 71HH OF 252 SHEETS

VIEW: CSB

DATUM
 VERTICAL NGVD 1929
 HORIZONTAL N/A

SCALE IN FEET

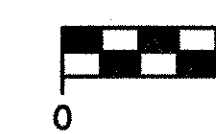

0 20