

SURV. 65+50

MATCH LINE

APPROXIMATE AREA OF ANEMONE MULTIFIDA FROM OCT. 20, 1986 MAP BY JENKINS & WARSHAW  
**DO NOT DISTURB**

**DO NOT DISTURB**  
APPROXIMATE AREA OF ANEMONE MULTIFIDA FROM OCT. 20, 1986 MAP BY JENKINS & WARSHAW

**SOIL INFORMATION**  
HIE: HARTLAND VERY FINE SANDY LOAM, 25-60% SLOPES  
HYDRIC SOIL GROUP B  
DEPTH TO BED ROCK: 60'  
DEPTH TO WATER TABLE: 6'  
HIGHLY ERODIBLE LAND  
K FACTOR = 0.49

**SOIL INFORMATION**  
AdB: ADAMS AND WINDSOR LOAMY SAND, 5-12% SLOPES  
HYDRIC SOIL GROUP A  
DEPTH TO BED ROCK: 60'  
DEPTH TO WATER TABLE: 6'  
POTENTIALLY ERODIBLE LAND  
K FACTOR = 0.17


**SOIL INFORMATION**  
Fu: FILL LAND, HYDRIC SOIL GROUP (NOT RATED)  
DEPTH TO BED ROCK: 60'  
DEPTH TO WATER TABLE: 6'  
ERODIBILITY (NOT RATED)  
K FACTOR = N/A

**NOTES:**

1. REFER TO THE CROSS SECTIONS FOR THE GRADE OF THE EXISTING AND PROPOSED CONDITIONS.
2. SOIL PROPERTIES AND BOUNDARIES WERE APPROXIMATED BASED ON USDA SOIL SURVEY. ACTUAL FIELD SURVEY MAY VARY.

VIEW: GS11

<b>DATUM</b>	
VERTICAL	NGVD 1929
HORIZONTAL	N/A

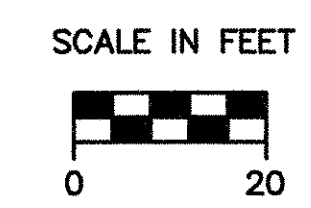

**EXISTING CONDITIONS SITE PLAN 11**

SURVEYED BY	CLD	DATE	7/89
DRAWN BY	TUS	DATE	10/93
SQUAD LEADER	JAW		
DESIGN FILE NO.	89-108		
IPARM FILE	DATE PLOTTED	JUL 30 2004	
PROJECT NAME:	BURLINGTON		
PROJECT NUMBER:	MEGC 5000(15)		
SHEET 710 OF 252 SHEETS			

