


MAG 1989

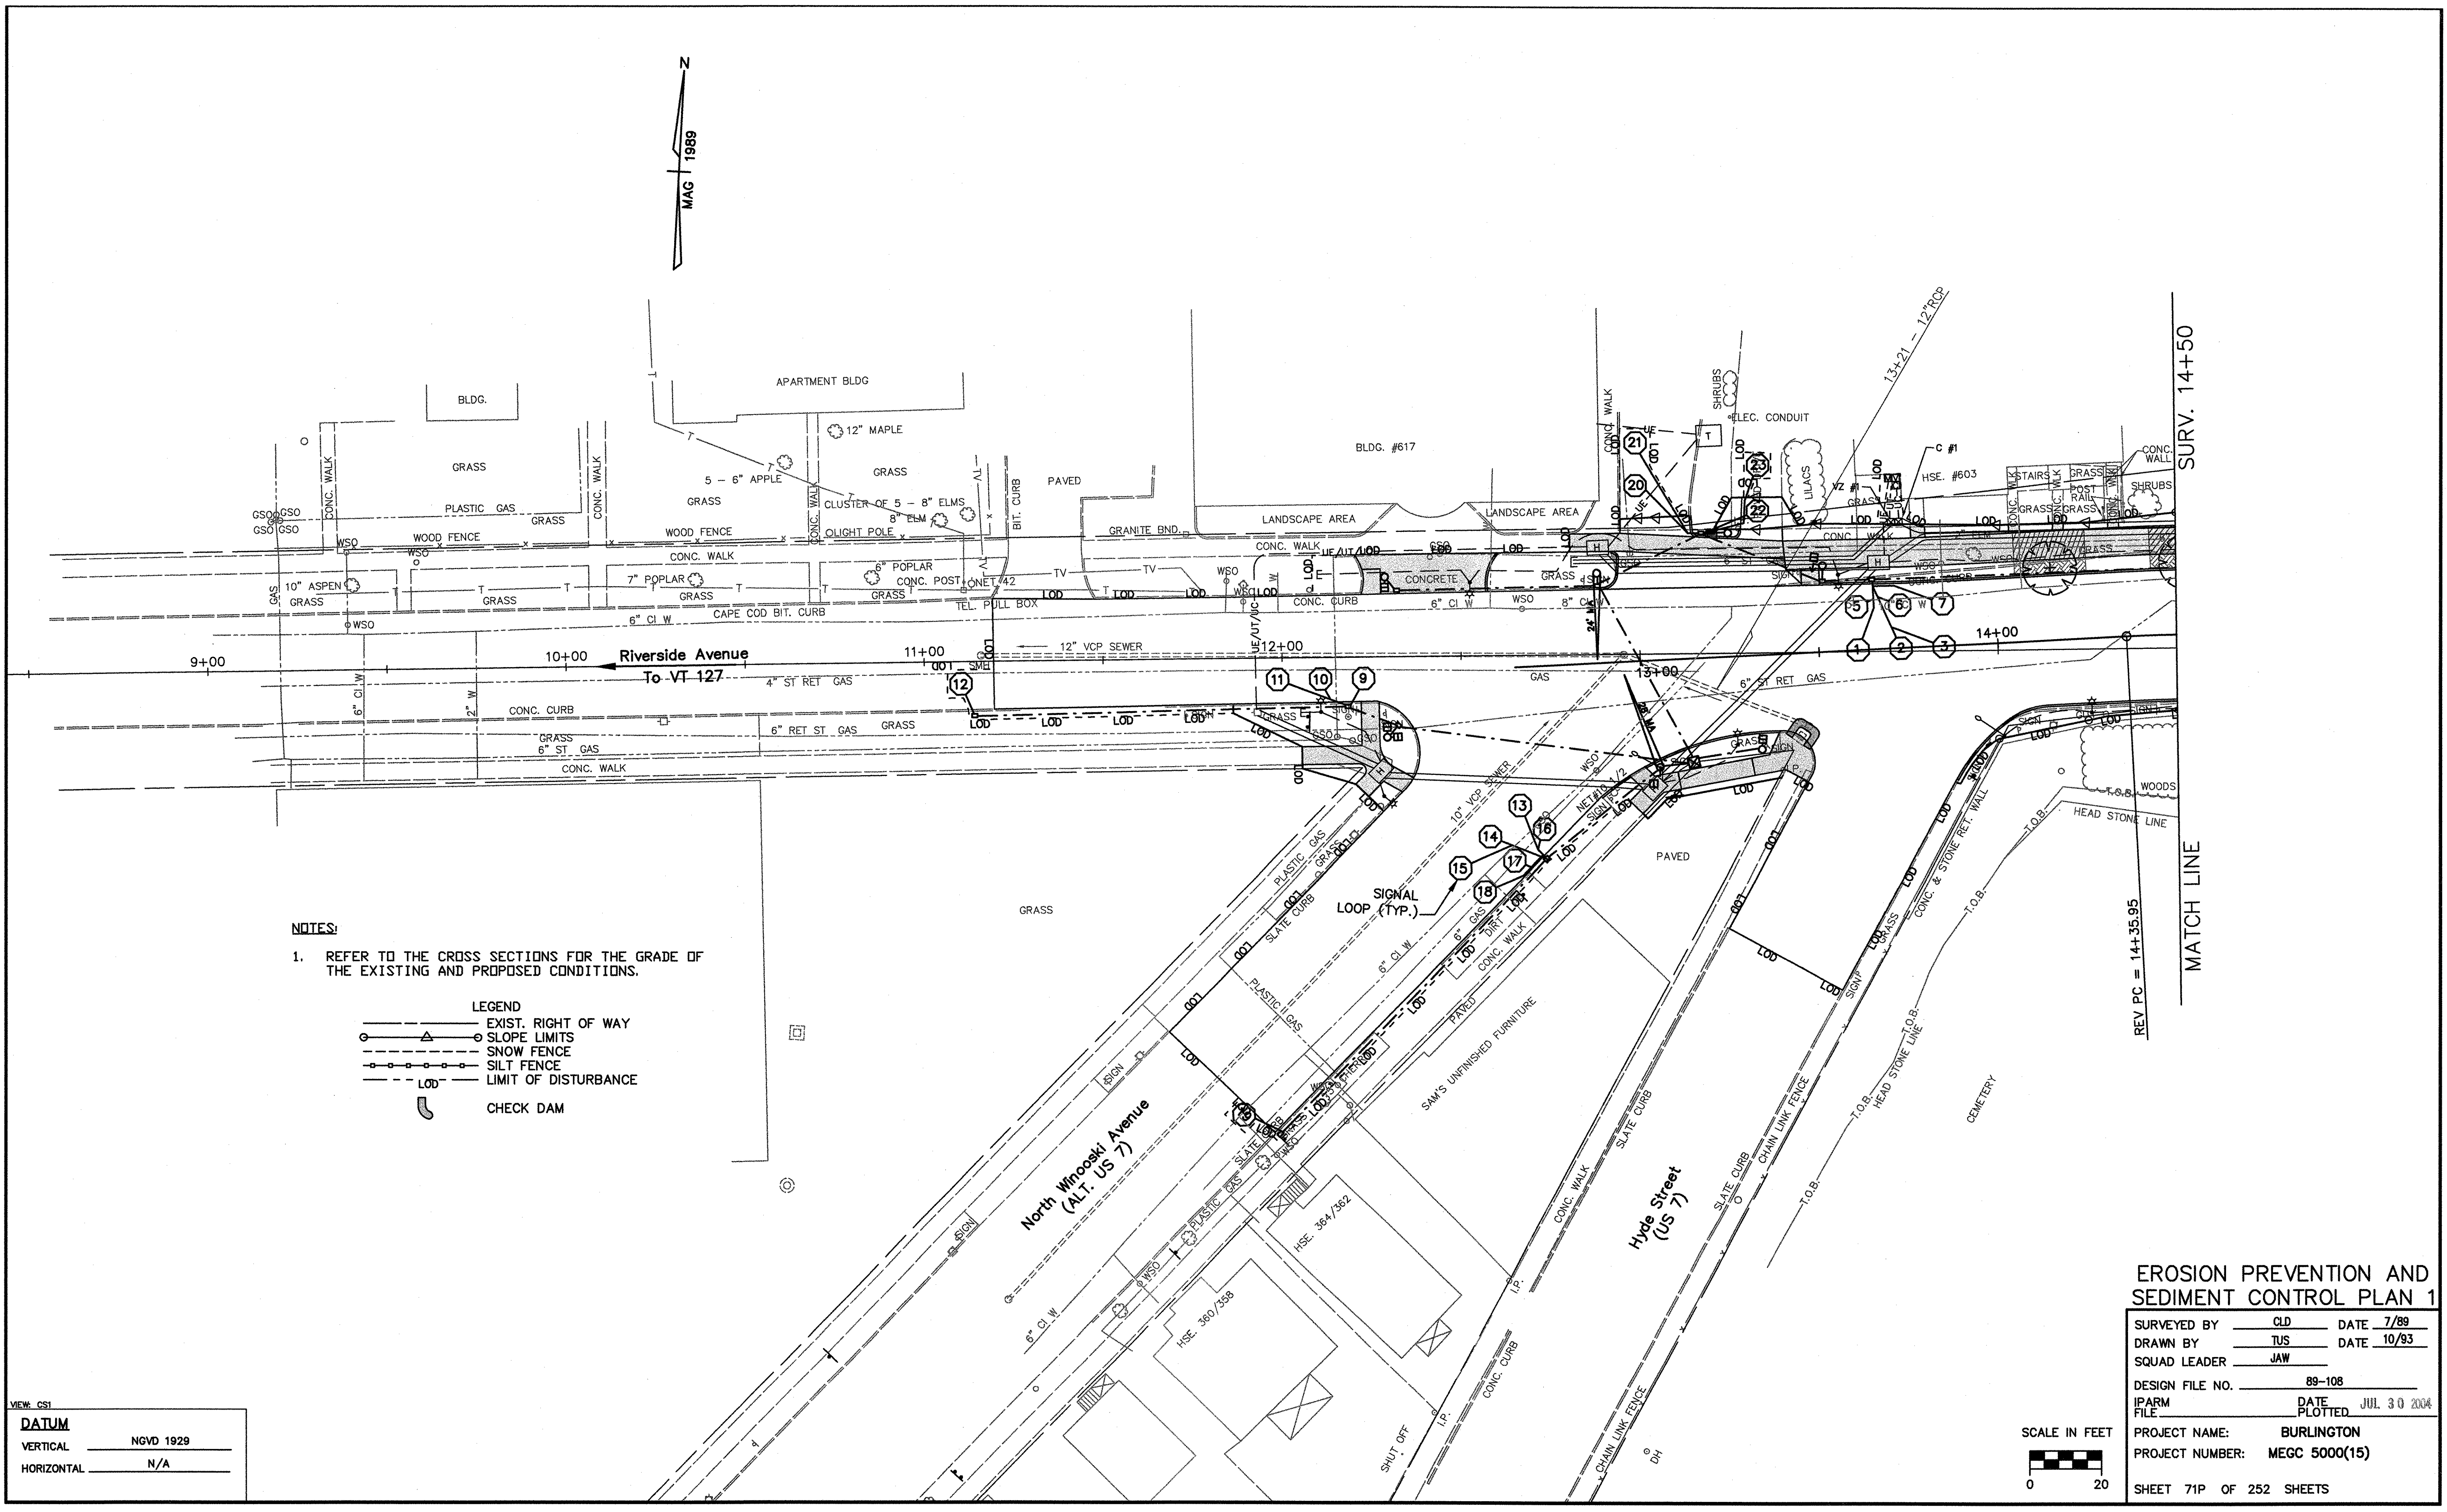


NOTES:

1. REFER TO THE CROSS SECTIONS FOR THE GRADE OF THE EXISTING AND PROPOSED CONDITIONS.

- LEGEND**
- EXIST. RIGHT OF WAY
 - SLOPE LIMITS
 - △ SNOW FENCE
 - SILT FENCE
 - LIMIT OF DISTURBANCE
 - CHECK DAM

VIEW: CS1
DATUM
 VERTICAL NGVD 1929
 HORIZONTAL N/A

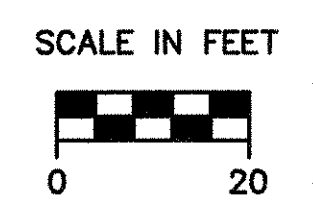

EROSION PREVENTION AND SEDIMENT CONTROL PLAN 1

SURVEYED BY	CLD	DATE	7/89
DRAWN BY	TUS	DATE	10/93
SQUAD LEADER	JAW		
DESIGN FILE NO.	89-108		
IPARM FILE		DATE PLOTTED	JUL 30 2004
PROJECT NAME:	BURLINGTON		
PROJECT NUMBER:	MEGC 5000(15)		
SHEET 71P OF 252 SHEETS			