



NOTES:
 1. REFER TO THE CROSS SECTIONS FOR THE GRADE OF THE EXISTING AND PROPOSED CONDITIONS.

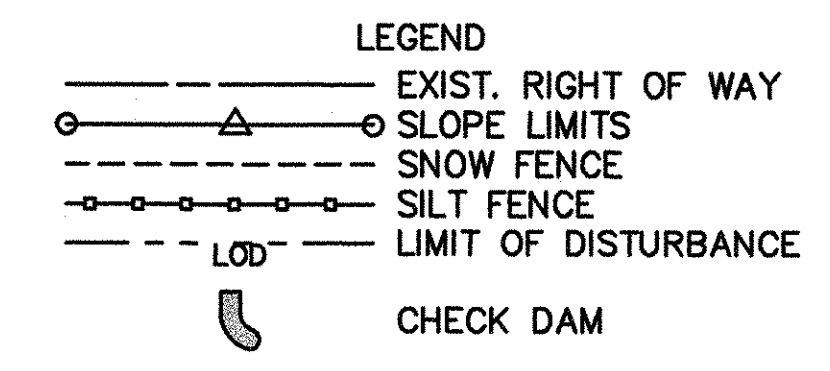

EROSION MATTING
 STA 20+50 - 21+00 LT

EROSION PREVENTION AND SEDIMENT CONTROL PLAN 3

SURVEYED BY	CLD	DATE	7/89
DRAWN BY	TUS	DATE	10/93
SQUAD LEADER	JAW		
DESIGN FILE NO.	89-108		
IPARM FILE		DATE PLOTTED	JUL 30 2004
PROJECT NAME:	BURLINGTON		
PROJECT NUMBER:	MEGC 5000(15)		
SHEET 71R OF 252 SHEETS			

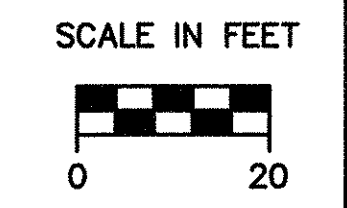

VIEW: G33

DATUM	
VERTICAL	NGVD 1929
HORIZONTAL	N/A