
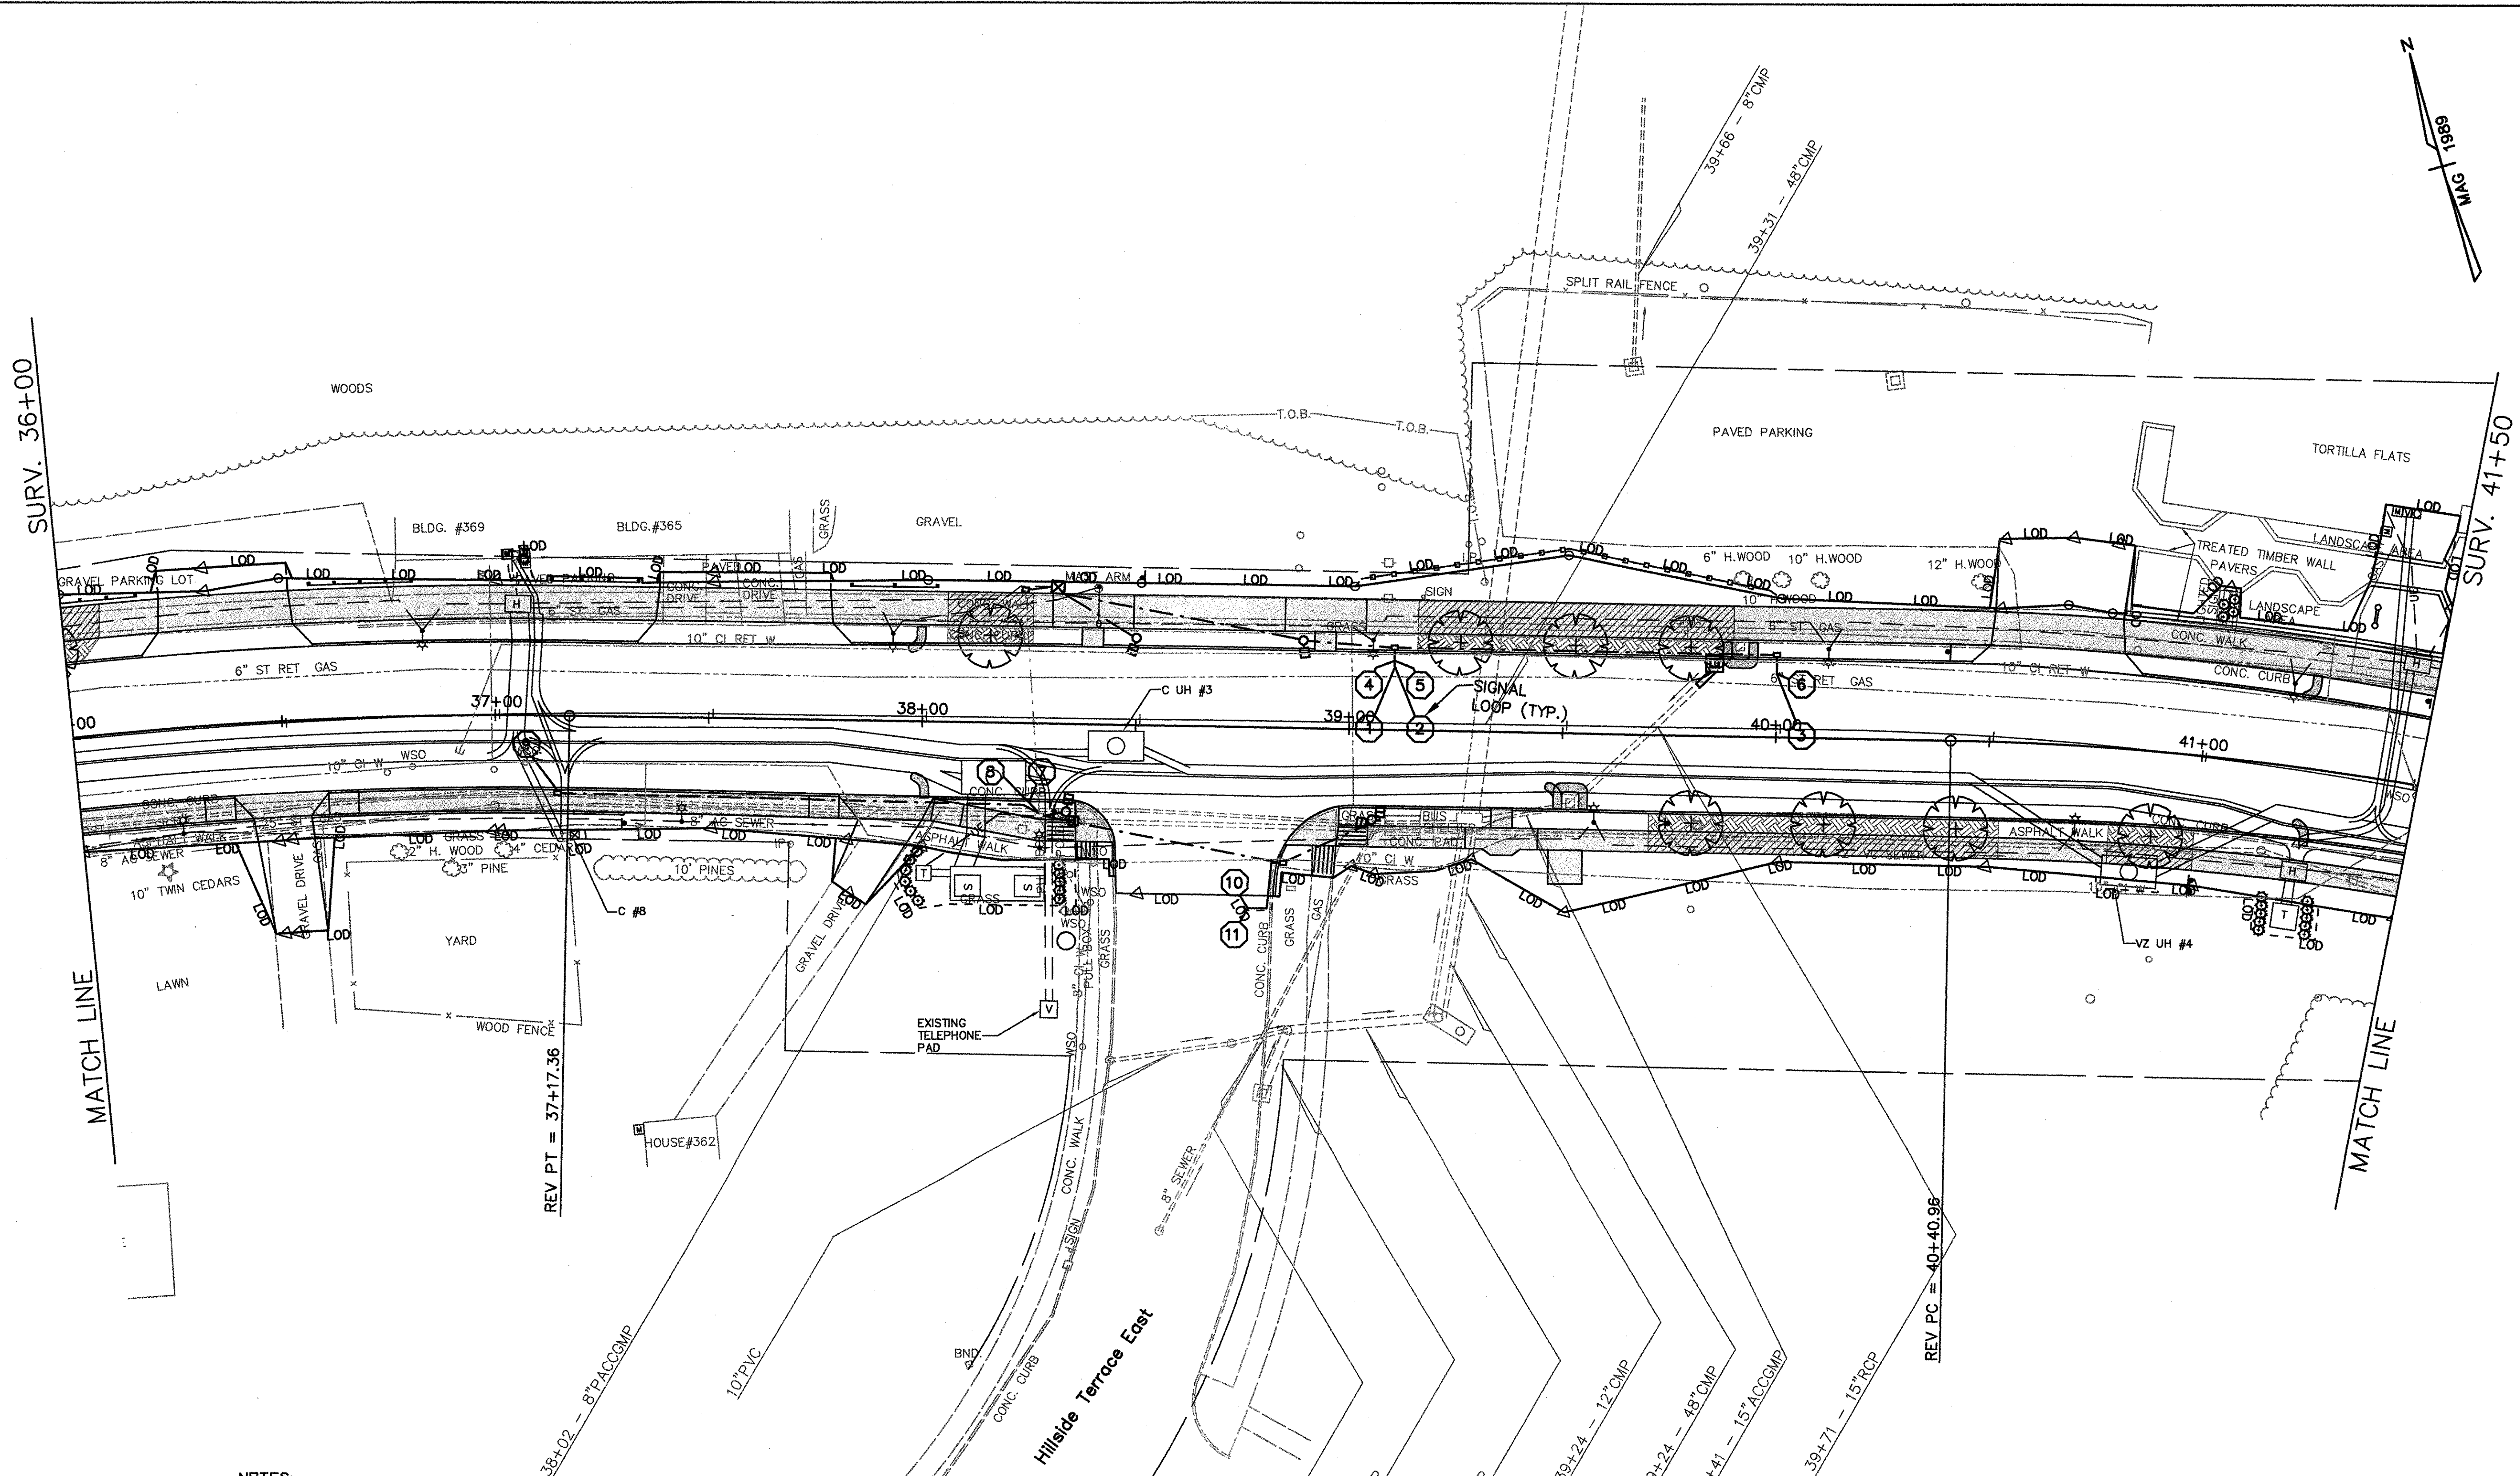


SURV. 36+00

SURV. 41+50

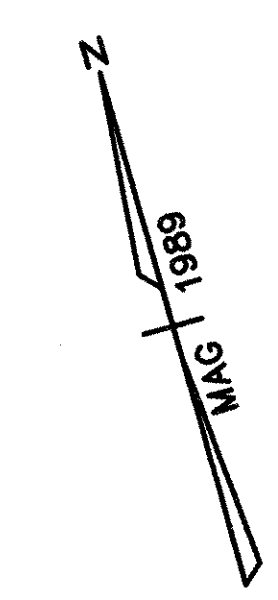

NOTES:
1. REFER TO THE CROSS SECTIONS FOR THE GRADE OF THE EXISTING AND PROPOSED CONDITIONS.

- LEGEND
- EXIST. RIGHT OF WAY
 - SLOPE LIMITS
 - SNOW FENCE
 - SILT FENCE
 - LOD LIMIT OF DISTURBANCE
 - CHECK DAM

EROSION MATTING
 STA 36+01 - 36+40 RT
 STA 36+60 - 37+80 RT
 STA 39+10 - 39+90 LT
 STA 41+00 - 41+51 RT

VIEW: CSS
 DATUM
 VERTICAL NGVD 1929
 HORIZONTAL N/A

EROSION PREVENTION AND
 SEDIMENT CONTROL PLAN 6

SURVEYED BY	CLD	DATE	7/89
DRAWN BY	TUS	DATE	10/93
SQUAD LEADER	JAW		
DESIGN FILE NO.	89-108		
IPARM FILE	DATE PLOTTED		
PROJECT NAME:	BURLINGTON		
PROJECT NUMBER:	MEGC 5000(15)		
SHEET 71U OF 252 SHEETS			

