


NOTES:
 1. REFER TO THE CROSS SECTIONS FOR THE GRADE OF THE EXISTING AND PROPOSED CONDITIONS.

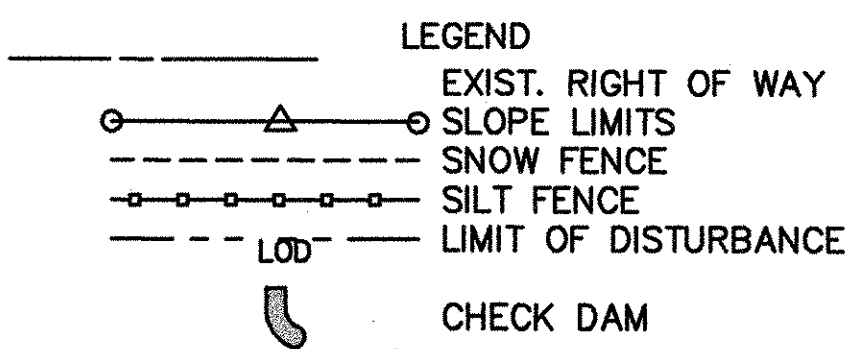


EROSION MATTING
 STA 41+51 - 44+50 RT
 STA 46+50 - 47+52 RT

SNOW FENCE (MOD)
 STA 43+25 - 43+60 LT

VIEW: CS7

DATUM
 VERTICAL NGVD 1929
 HORIZONTAL N/A

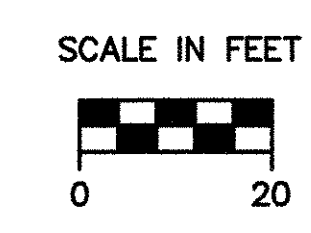

EROSION PREVENTION AND SEDIMENT CONTROL PLAN 7

SURVEYED BY	CLD	DATE	7/89
DRAWN BY	TUS	DATE	10/93
SQUAD LEADER	JAW		
DESIGN FILE NO.	89-108		
IPARM FILE		DATE PLOTTED	JUL 30 2004
PROJECT NAME:	BURLINGTON		
PROJECT NUMBER:	MEGC 5000(15)		
SHEET 71V OF 252 SHEETS			