


EROSION MATTING
 STA 61+50 - 63+00 LT


SNOW FENCE
 STA 59+53 - 64+00 LT
 STA 65+15 - 65+62 LT

- NOTES:**
- REFER TO THE CROSS SECTIONS FOR THE GRADE OF THE EXISTING AND PROPOSED CONDITIONS.

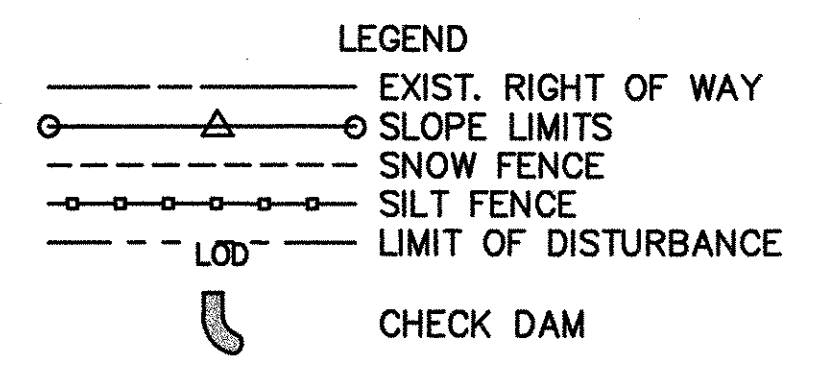

VIEW: CS10

DATUM	
VERTICAL	NGVD 1929
HORIZONTAL	N/A

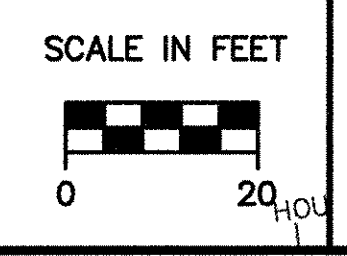

EROSION PREVENTION AND SEDIMENT CONTROL PLAN 10

SURVEYED BY	CLD	DATE	7/89
DRAWN BY	TUS	DATE	10/93
SQUAD LEADER	JAW		
DESIGN FILE NO.	89-108		
IPARM FILE		DATE PLOTTED	JUL 30 2004
PROJECT NAME:	BURLINGTON		
PROJECT NUMBER:	MEGC 5000(15)		
SHEET 71Y OF 252 SHEETS			