


SURV. 65+50

MATCH LINE

APPROXIMATE AREA OF ANEMONE MULTIFIDA FROM OCT. 20, 1986 MAP BY JENKINS & WARSHAW DO NOT DISTURB

DO NOT DISTURB APPROXIMATE AREA OF ANEMONE MULTIFIDA FROM OCT. 20, 1986 MAP BY JENKINS & WARSHAW

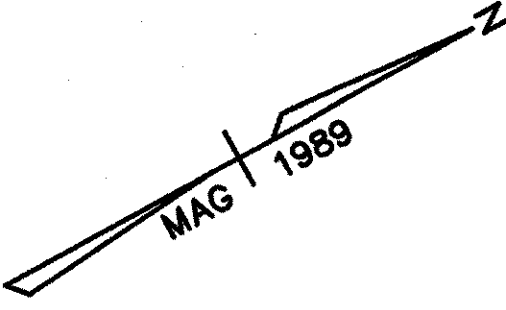

SENSITIVE AREA

SENSITIVE AREA

RUBBLE FROM FOUNDATION MILL 2

MILL 21

MILL 9

MILL 41

MILL 1

CONC. WALK

CONC. WALK

24" RC SEWER

Riverside Avenue

US 7 To Winooski

66+00

67+00

68+00

69+00

70+00

71+00

8" ST GAS

8" ST GAS

8" ST GAS

8" ST GAS

RET. GAS

RC SEWER

CONC. CURB

LANDSCAPE SIGN

HOUSE #460&462

PAVED DRIVE

CONC. WALK

2" GAS

CONC. WALK

6" RET. GAS

CONC. WALK

8" ST GAS

CONC. WALK

8" ST GAS

EROSION MATTING STA 66+50 - 67+50 LT

SNOW FENCE STA 65+62 - 71+00 LT

NOTES:

1. REFER TO THE CROSS SECTIONS FOR THE GRADE OF THE EXISTING AND PROPOSED CONDITIONS.

- LEGEND
- EXIST. RIGHT OF WAY
 - SLOPE LIMITS
 - SNOW FENCE
 - SILT FENCE
 - LIMIT OF DISTURBANCE
 - CHECK DAM

VIEW: CS11

DATUM	
VERTICAL	NGVD 1929
HORIZONTAL	N/A

EROSION PREVENTION AND SEDIMENT CONTROL PLAN 11

SURVEYED BY	CLD	DATE	7/89
DRAWN BY	TUS	DATE	10/93
SQUAD LEADER	JAW		
DESIGN FILE NO.	89-108		
IPARM FILE	DATE PLOTTED JUL 30 2004		
PROJECT NAME:	BURLINGTON		
PROJECT NUMBER:	MEGC 5000(15)		
SHEET 71Z OF 252 SHEETS			

