

SURV. 30+00

SURV. 36+00

MATCH LINE

MATCH LINE


REV PT = 31+98.85

REV PC = 35+41.47

Hillside Terrace West

VIEW: GSS

<b>DATUM</b>	
VERTICAL	NGVD 1929
HORIZONTAL	N/A

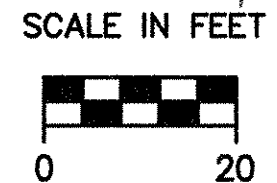

<b>PAVEMENT LAYOUT PLAN</b>			
SURVEYED BY	CLD	DATE	7/89
DRAWN BY	TUS	DATE	10/93
SQUAD LEADER	JAW		
DESIGN FILE NO.	89-108		
IPARM FILE		DATE PLOTTED	JUL 30 2004
PROJECT NAME:	BURLINGTON		
PROJECT NUMBER:	MEGC 5000(15)		
SHEET 76 OF 252 SHEETS			