

SURV. 36+00

SURV. 41+50

MATCH LINE

MATCH LINE


REV PT = 37+17.36

REV PC = 40+40.96

Hillside Terrace East

VIEW: CS6

<b>DATUM</b>	
VERTICAL	NGVD 1929
HORIZONTAL	N/A

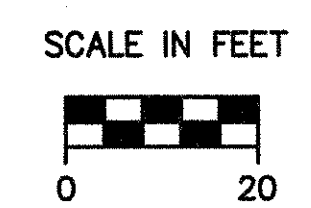

**PAVEMENT LAYOUT PLAN**

SURVEYED BY	CLD	DATE	7/89
DRAWN BY	TUS	DATE	10/93
SQUAD LEADER	JAW		
DESIGN FILE NO.	89-108		
IPARM FILE		DATE PLOTTED	
PROJECT NAME:	BURLINGTON		
PROJECT NUMBER:	MEGC 5000(15)		
SHEET	77	OF	252 SHEETS