


VIEW: CS9  
**DATUM**  
 VERTICAL NGVD 1929  
 HORIZONTAL N/A

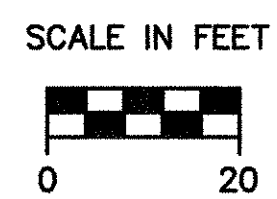

**PAVEMENT LAYOUT PLAN**

SURVEYED BY	CLD	DATE	7/89
DRAWN BY	TUS	DATE	10/93
SQUAD LEADER	JAW		
DESIGN FILE NO.	89-108		
IPARM FILE		DATE PLOTTED	JUL 30 2004
PROJECT NAME:	BURLINGTON		
PROJECT NUMBER:	MEGC 5000(15)		
SHEET 80 OF 252 SHEETS			