
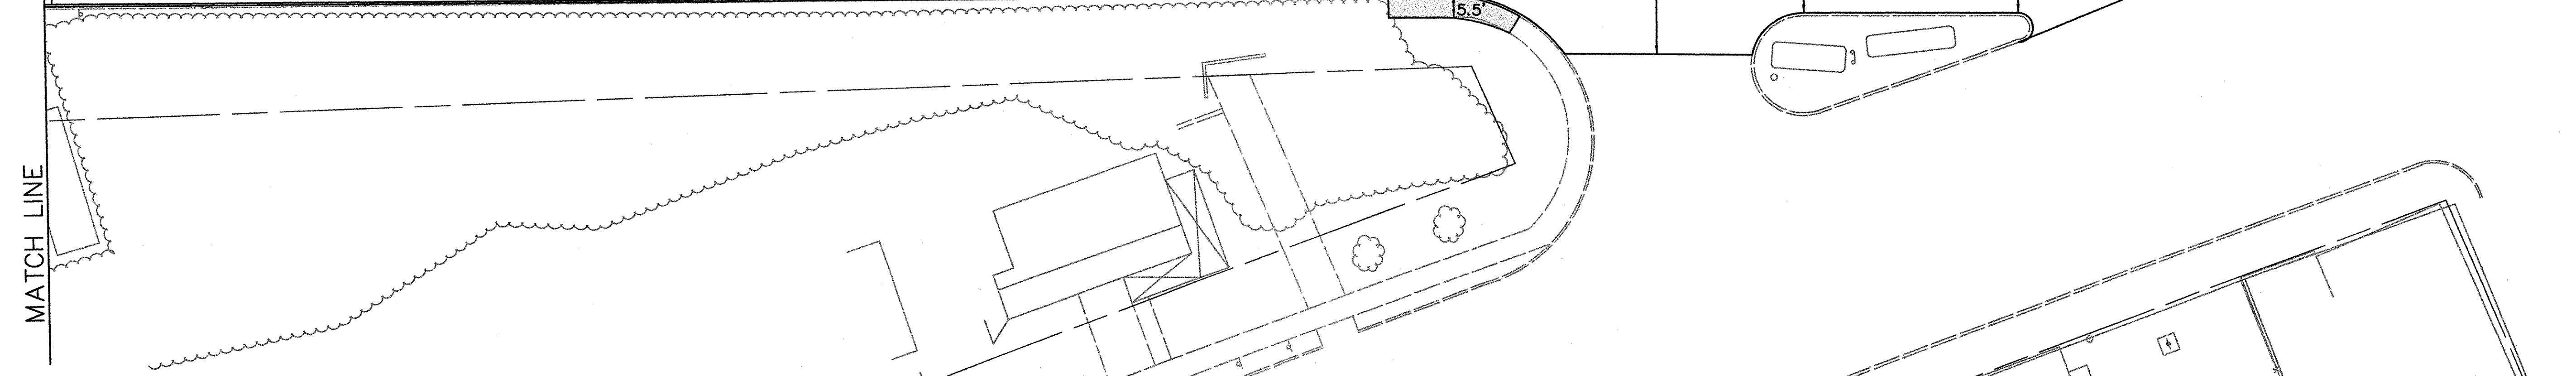
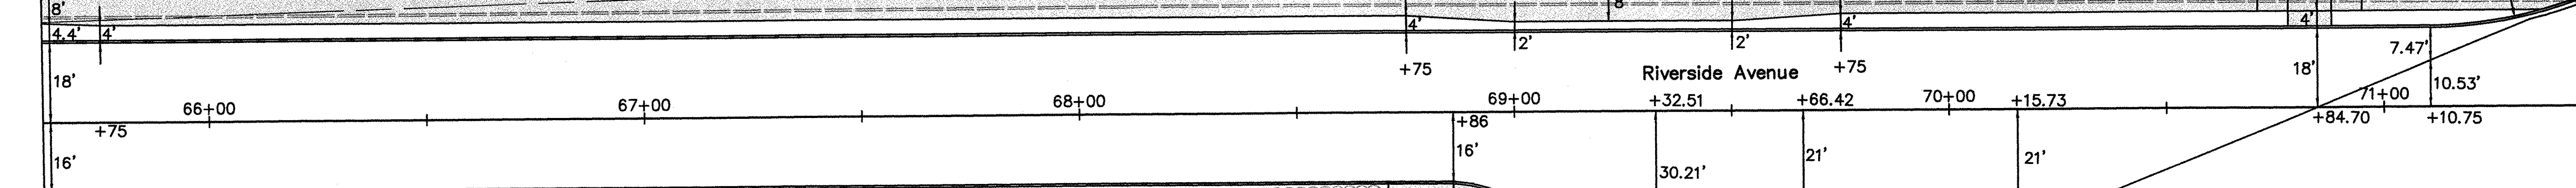
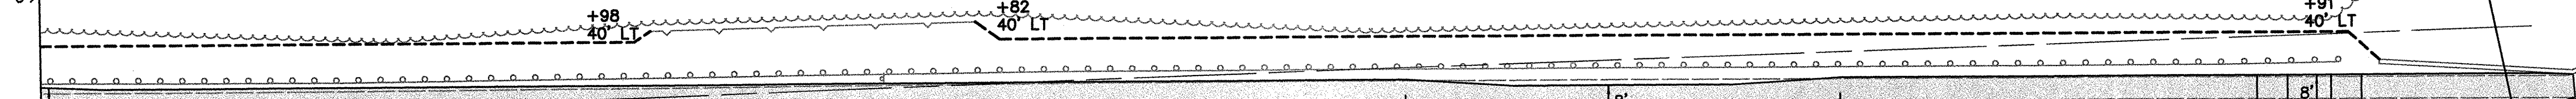


SURV. 65+50

MATCH LINE

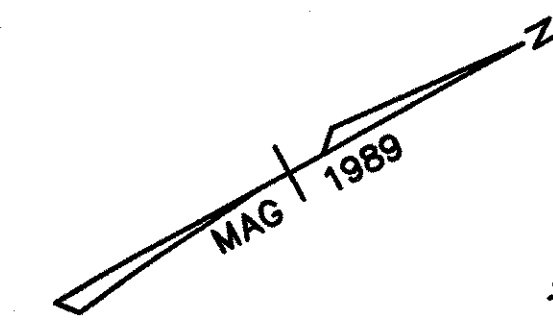

US 7
To Winoski

Mill Street


Barrett Street

Colchester Avenue

Riverside Avenue

PAVEMENT LAYOUT PLAN

SURVEYED BY	CLD	DATE	7/89
DRAWN BY	TUS	DATE	10/93
SQUAD LEADER	JAW		
DESIGN FILE NO.	89-108		
IPARM FILE	DATE PLOTTED JUN 30 2004		
PROJECT NAME:	BURLINGTON		
PROJECT NUMBER:	MEGC 5000(15)		
SHEET 82 OF 252 SHEETS			

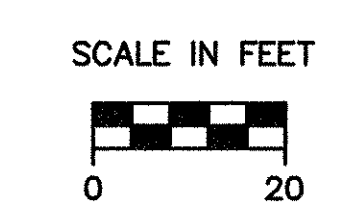

VIEW	CS11
DATUM	
VERTICAL	NGVD 1929
HORIZONTAL	N/A