


BELD HH #1
ELIMINATED

BELD HH #2
13+68 29.5' LT

BELD HH #22
12+10 27' RT

BELD HH #3
13+03.5 38' RT

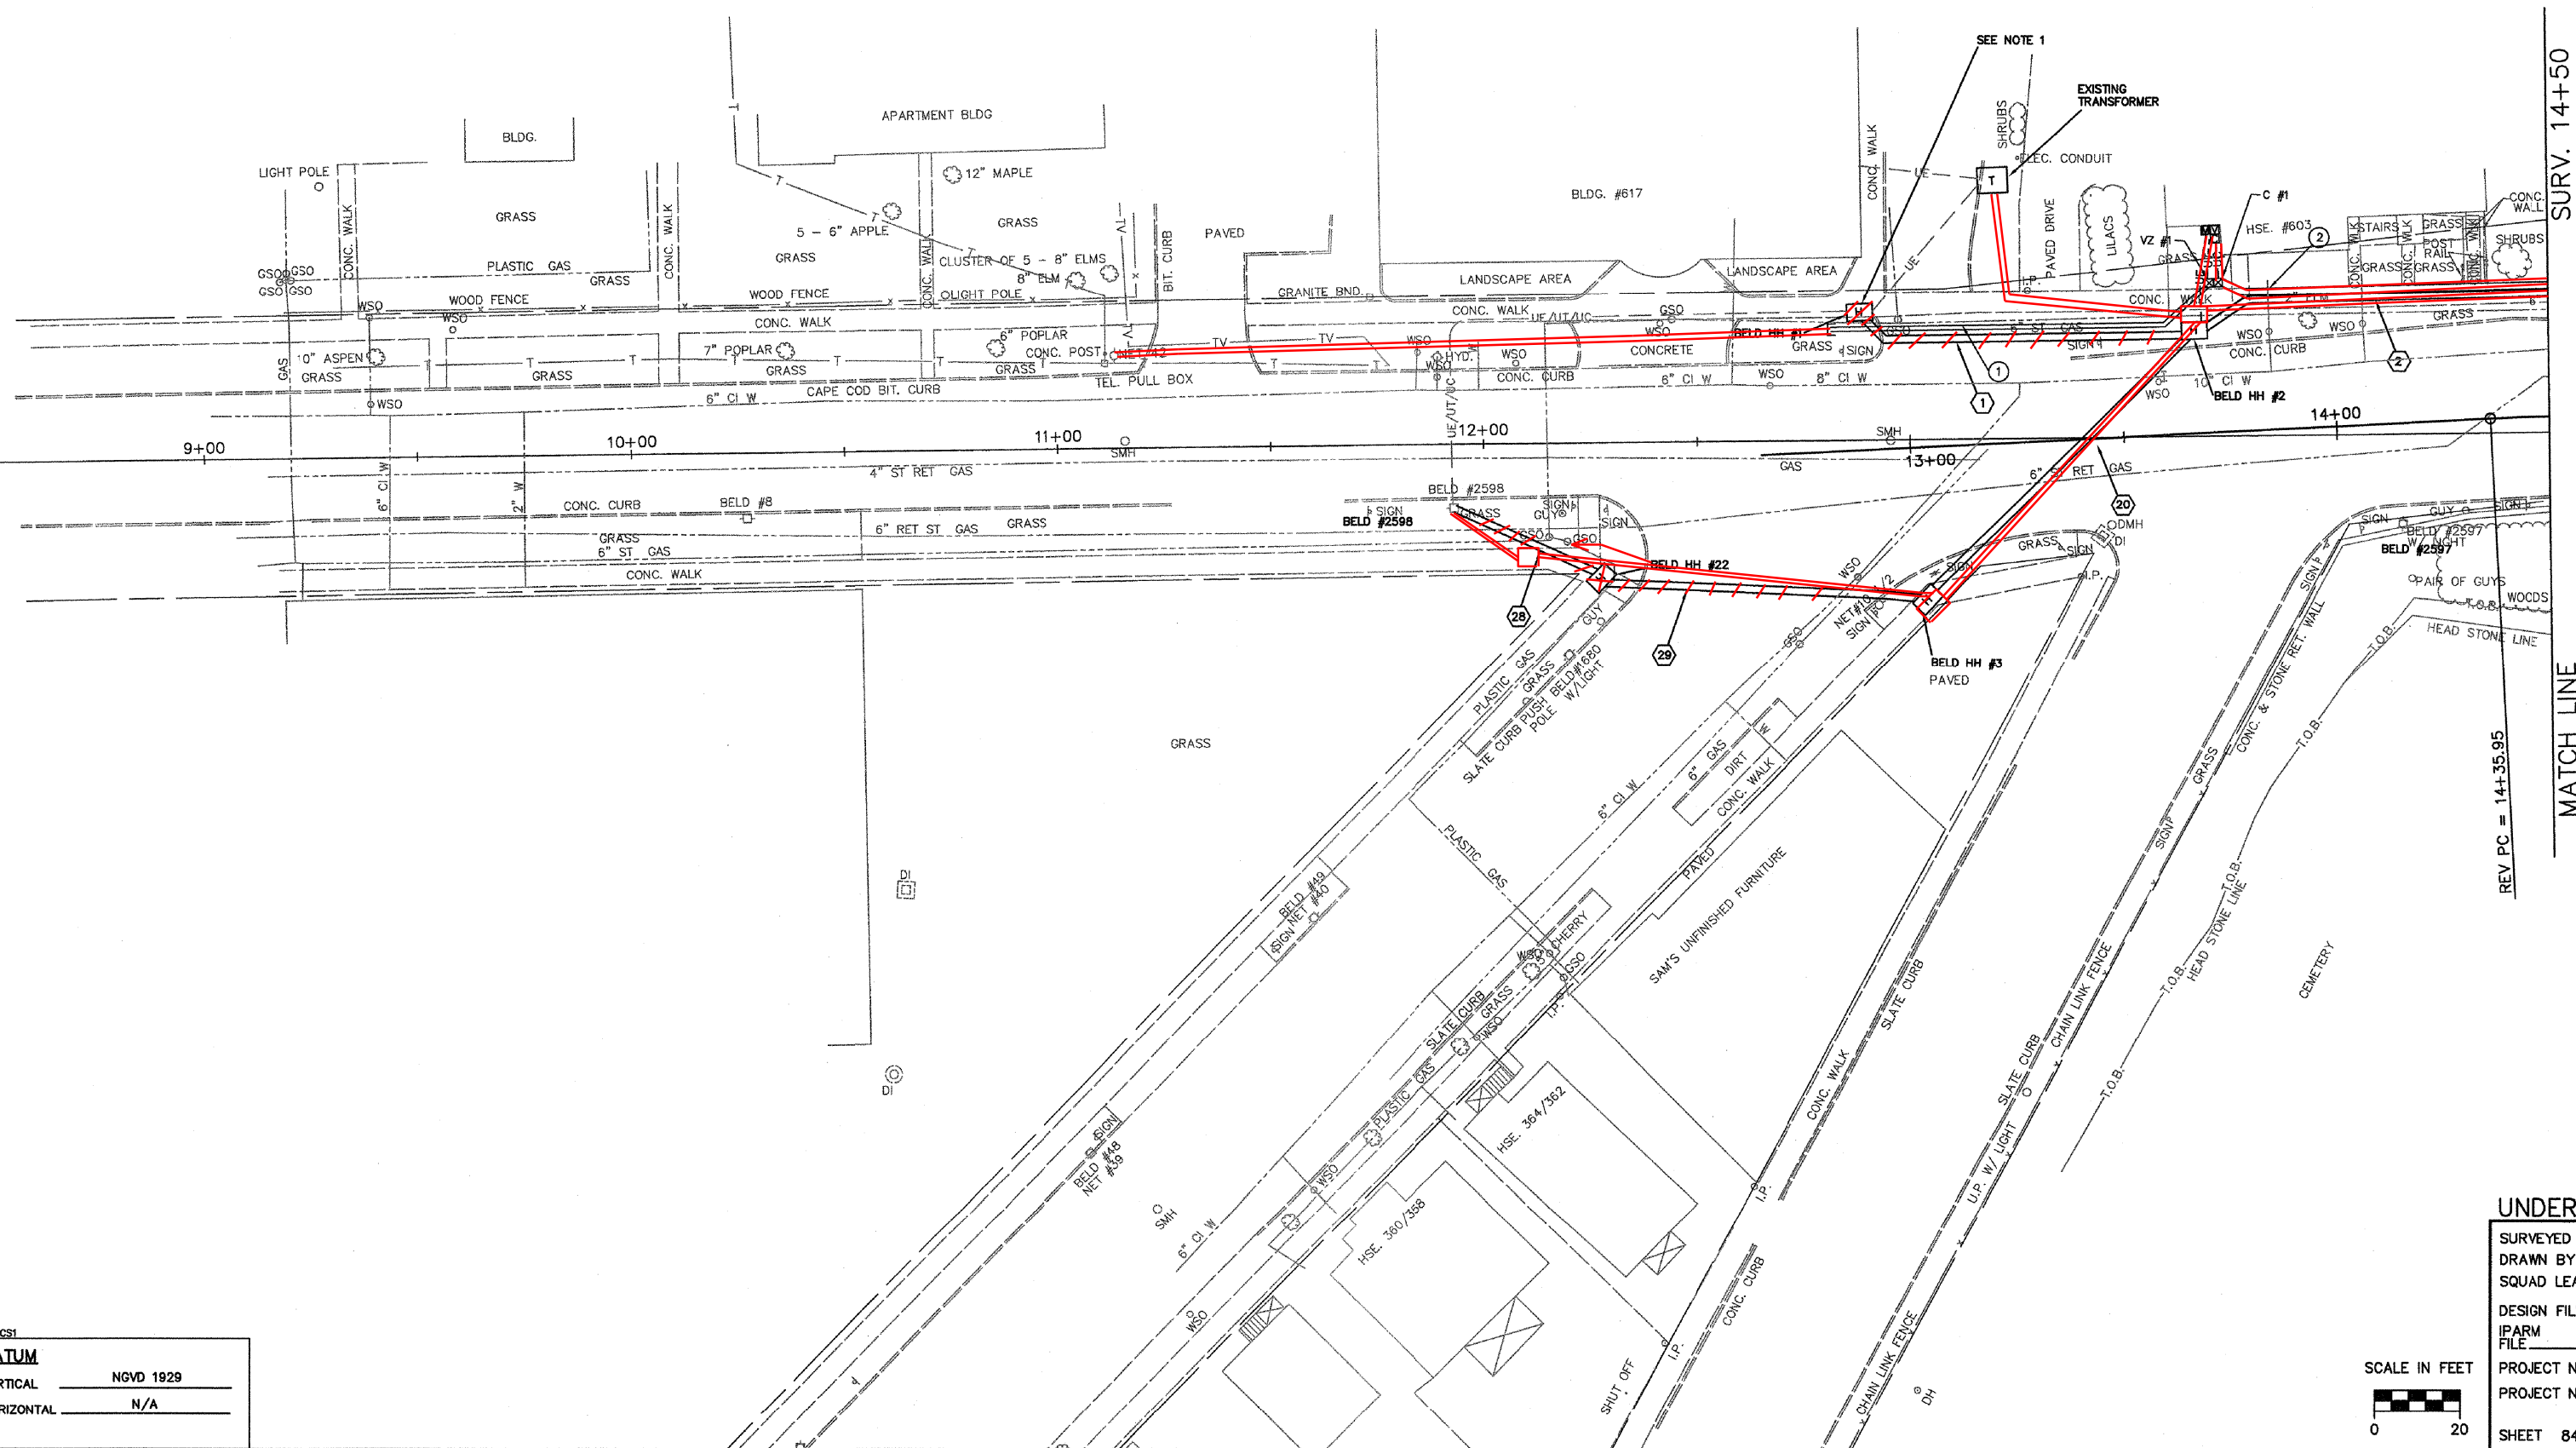

SURV. 14+50

MATCH LINE

REV PC = 14+35.95

VIEW: CS1

DATUM	
VERTICAL	NGVD 1929
HORIZONTAL	N/A

UNDERGROUND UTILITY PLAN

SURVEYED BY	CLD	DATE	7/89
DRAWN BY	TUS	DATE	10/93
SQUAD LEADER	JAW		
DESIGN FILE NO.	89-108		
IPARM FILE		DATE PLOTTED	JUL 30 2004
PROJECT NAME:	BURLINGTON		
PROJECT NUMBER:	MEGC 5000(15)		
SHEET	84	OF 252 SHEETS	

