

MAG 1989

MATCH LINE

SURV. 24+00

MATCH LINE

SURV. 20+50


BED HH #5
21+53 27.0' LT

C UH #1
22+93 50.5' RT

STEEL MARKER POSTS (MOD-BOLLARDS, SINGLE)
REV 22+11 LT (1, UTILITY PLACEMENT)
REV 23+30 RT (1, UTILITY PLACEMENT)

UNDERGROUND UTILITY PLAN

SURVEYED BY	GLD	DATE	7/89
DRAWN BY	TUS	DATE	10/93
SQUAD LEADER	JAW		
DESIGN FILE NO.	89-108		
IPARM FILE		DATE PLOTTED	JUN 30 2004
PROJECT NAME:	BURLINGTON		
PROJECT NUMBER:	MEGC 5000(15)		
SHEET 86 OF 252 SHEETS			

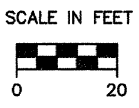

VIEW: CS3

DATUM	
VERTICAL	NGVD 1929
HORIZONTAL	N/A

