

C UH #2
35+39 35.0' RT

VZ UH #3
35+44 38.0' RT

BELD HH #10
34+07 26.5' LT

BELD HH #11
35+57 52.5' RT

BELD HH #9
34+21 25.0' RT

T #15
34+92 39.0' RT

NEW BOLLARD (3)

1- BOLLARD

1 VERMONT PARK

2 VERMONT PARK

4 VERMONT PARK

REV PT = 31+98.85

SURV. 30+00


SURV. 36+00

MATCH LINE

MATCH LINE

UNDERGROUND UTILITY PLAN

| | | | |
|------------------------|---------------|--------------|-------------|
| SURVEYED BY | CLD | DATE | 7/89 |
| DRAWN BY | TUS | DATE | 10/93 |
| SQUAD LEADER | JAW | | |
| DESIGN FILE NO. | 89-108 | | |
| IPARM FILE | | DATE PLOTTED | JUL 30 2000 |
| PROJECT NAME: | BURLINGTON | | |
| PROJECT NUMBER: | MEGC 5000(15) | | |
| SHEET 88 OF 252 SHEETS | | | |

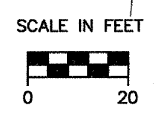

VIEW: CSS

| | |
|--------------|-----------|
| DATUM | |
| VERTICAL | NGVD 1929 |
| HORIZONTAL | N/A |

