


BELD HH #14  
41+64 27.5' RT

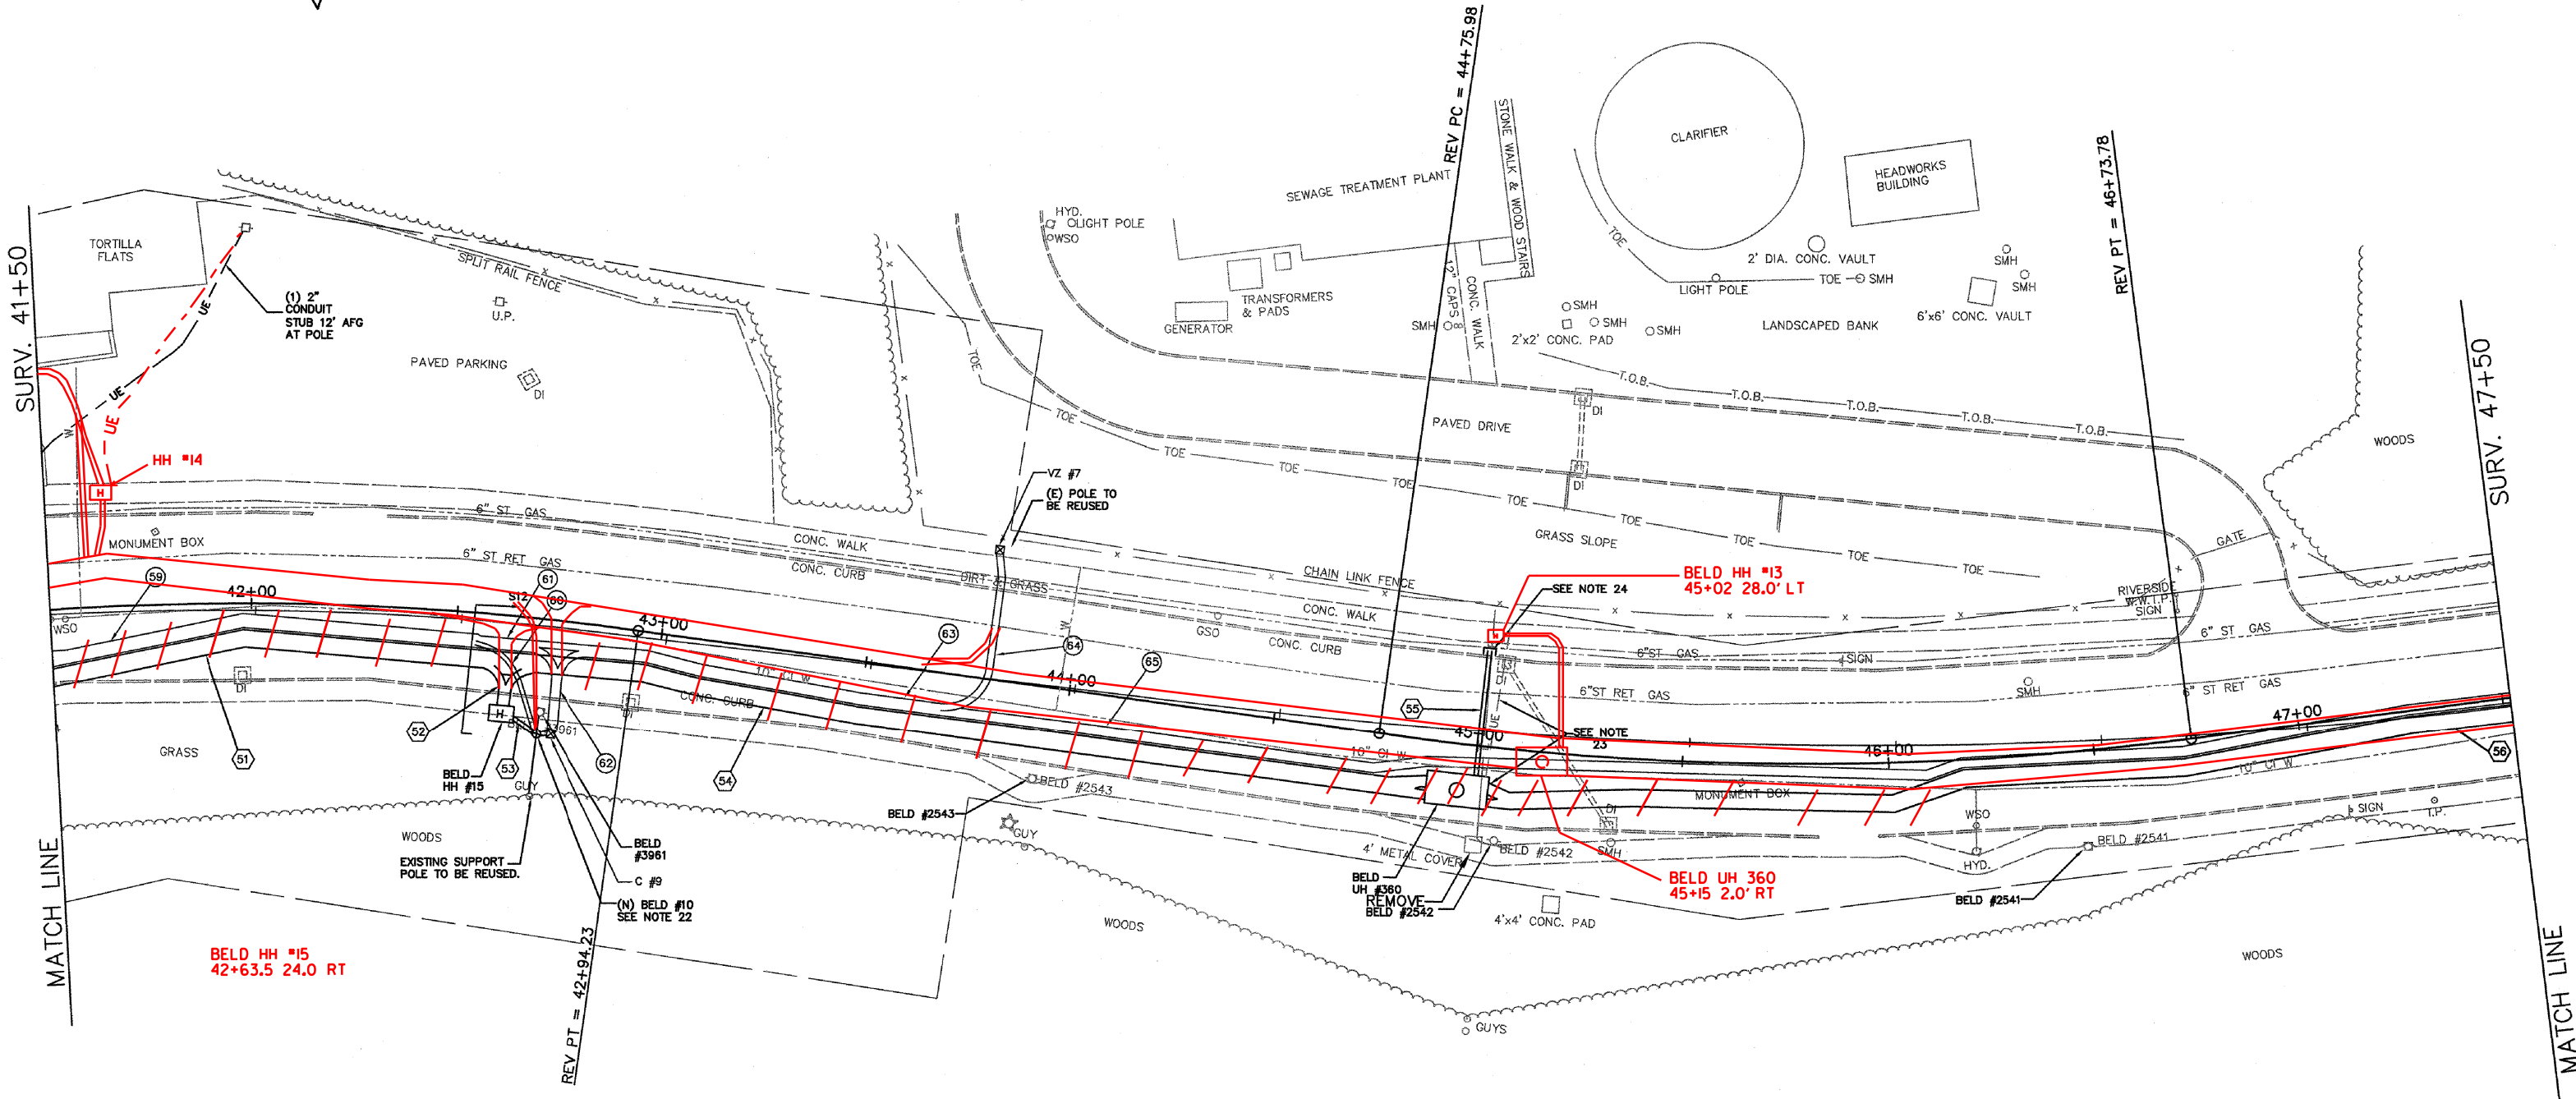

BELD HH #15  
42+63.5 24.0 RT

BELD HH #13  
45+02 28.0' LT

BELD UH 360  
45+15 2.0' RT

VIEW: CS7

DATUM  
VERTICAL NGVD 1929  
HORIZONTAL N/A

UNDERGROUND UTILITY PLAN

SURVEYED BY	GLD	DATE	7/89
DRAWN BY	TUS	DATE	10/93
SQUAD LEADER	JAW		
DESIGN FILE NO.	89-108		
IPARM FILE		DATE PLOTTED	JUL 30 2004
PROJECT NAME:	BURLINGTON		
PROJECT NUMBER:	MEGC 5000(15)		
SHEET 90 OF 252 SHEETS			

