


T #12
59+55.5 43.5' RT

T #11
59+62.5 43.5' RT

T #34
59+74 43.0' RT

12" POPLAR

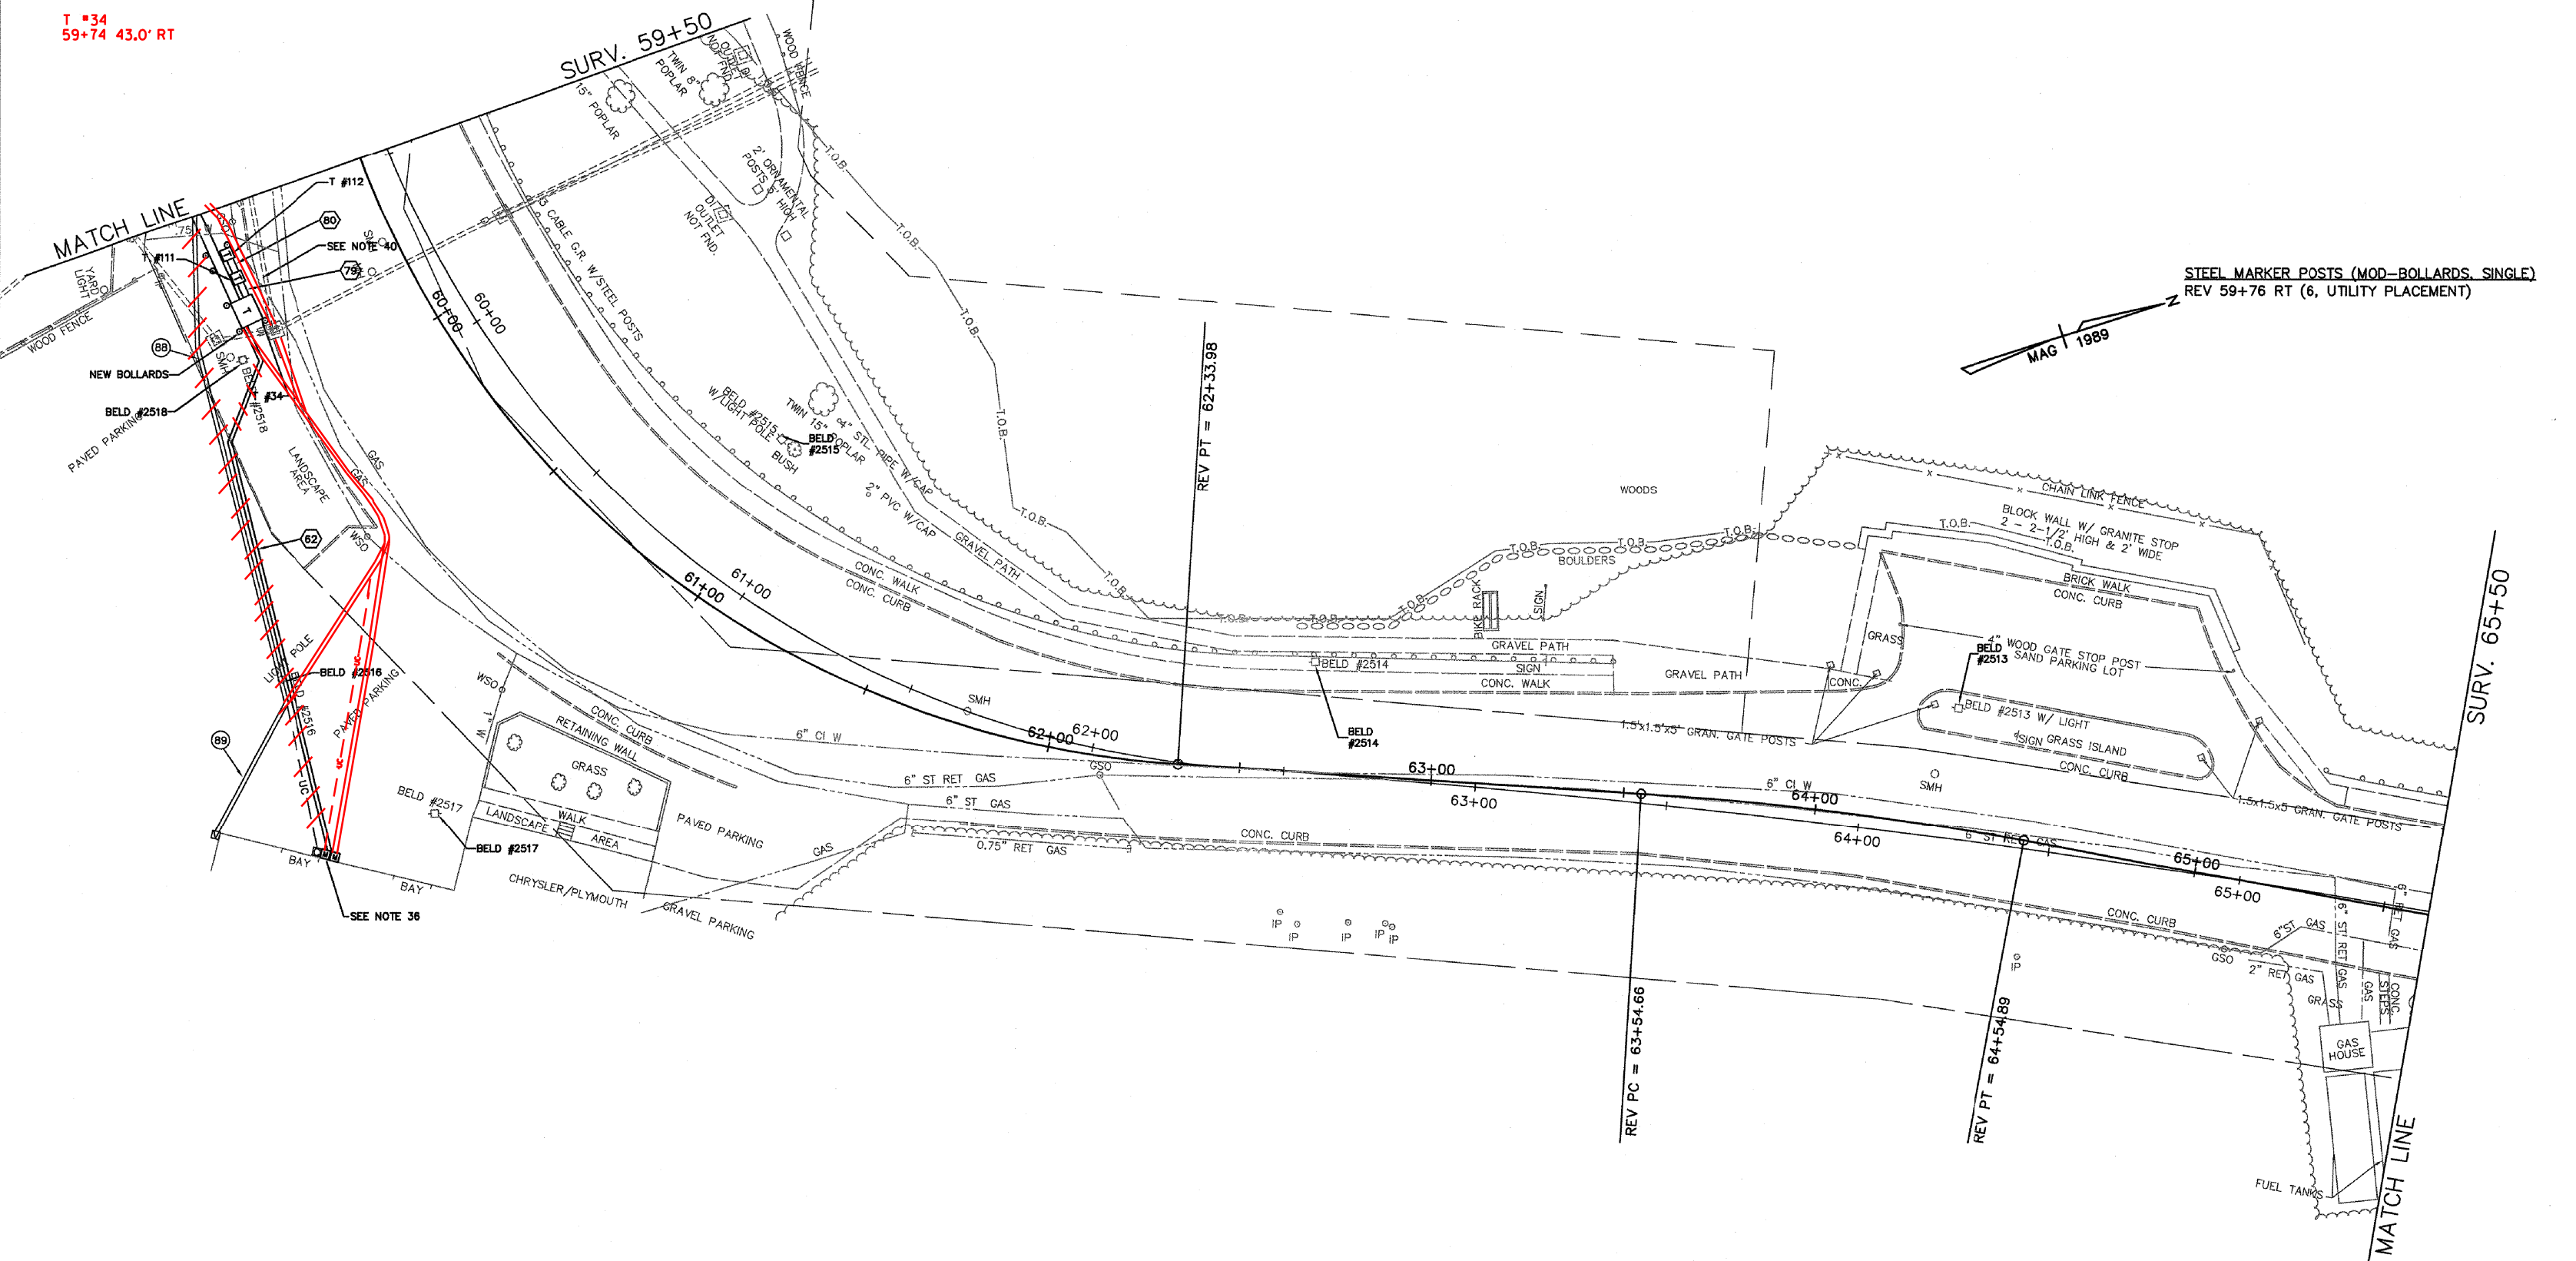

VIEW: CS10

DATUM

VERTICAL NGVD 1929

HORIZONTAL N/A

UNDERGROUND UTILITY PLAN

SURVEYED BY	CLD	DATE	7/89
DRAWN BY	TUS	DATE	10/93
SQUAD LEADER	JAW		
DESIGN FILE NO.	89-108		
IPARM FILE	DATE PLOTTED	JUN 30 2004	
PROJECT NAME:	BURLINGTON		
PROJECT NUMBER:	MEGC 5000(15)		
SHEET 93 OF 252 SHEETS			

