

STREET LIGHTING LOCATIONS SCHEDULE							
STREET LIGHT NO.	POLE LOCATION	POLE OFFSET	LUMINAIRE TYPE	POLE TYPE	LUMINAIRE MOUNTING HEIGHT	BRACKET ARM LENGTH	REMARKS
SL- 1A	12 +28.4'	39.3' R	A	A	22'	29"	
SL- 1B	13 +04.6'	30.5' R	B2	TRAFFIC SIGNAL POLE	30'	8'	PROVIDED BY TRAFFIC SIGNAL CONTRACTOR
SL- 1C	12 +10.7'	15.2' R	A	A	22'	29"	
SL- 2	12 +52.5'	20.8' L	A	A	22'	29"	
SL- 4	13 +56.4'	21.3' L	A	A	22'	29"	
SL- 3A	13 +26.0'	24.7' R	A	A	22'	29"	
SL- 3B	14 +00.0'	26.0' R	B1	B1	30'	8'	
SL- 5	14 +25.2'	20.8' R	A	A	22'	29"	


MATCHLINE - SHEET SL2, STATION 14+50

DATUM NATIONAL GEODETIC
 VERTICAL VERTICAL DATUM 1929
 HORIZONTAL N/A

LEGEND

- STREET LIGHTING AND ELECTRICAL CONDUIT
- [H] SL HH#X = STREET LIGHTING HANDHOLE
- ☼ TYPE A STREET LIGHT
- ⊙ TYPE B STREET LIGHT
- BURIED CONDUIT SWEEP WITH CAP FOR FUTURE USE

SCALE IN FEET

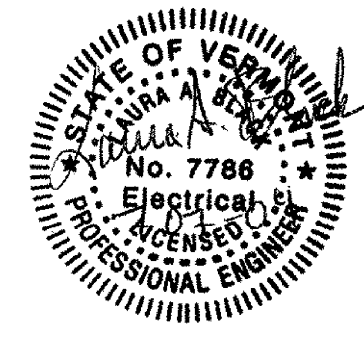

STREET LIGHTING LAYOUT PLANS

SHEET SL1

SURVEYED BY CLD DATE 07/89
 DRAWN BY MLC/JTM/PBH DATE 06/03
 DESIGN BY LAB/MLC
 DESIGN FILE NO. _____
 PRF FILE - _____ DATE PLOTTED 10/03
 PROJ. NAME BURLINGTON
 PROJ. NO. MEGC 5000(15)
 SHEET 102 OF 252 SHEETS