

DATUM NATIONAL GEODETIC  
 VERTICAL VERTICAL DATUM 1929  
 HORIZONTAL N/A


21.1' R

STREET LIGHTING LOCATIONS SCHEDULE							
STREET LIGHT NO.	POLE LOCATION	POLE OFFSET	LUMINAIRE TYPE	POLE TYPE	LUMINAIRE MOUNTING HEIGHT	BRACKET ARM LENGTH	REMARKS
SL- 6	14 +74.4'	20.7' L	A	A	22'	29"	
SL- 7	15 +27.3'	20.4' R	A	A	22'	29"	
SL- 8	15 +81.3'	20.8' L	A	A	22'	29"	
SL- 9	16 +41.7'	21.1' R	A	A	22'	29"	
SL- 10	16 +98.7'	20.8' L	A	A	22'	29"	
SL- 11	17 +53.2'	21.1' R	A	A	22'	29"	
SL- 12	18 +14.9'	20.8' L	A	A	22'	29"	
SL- 13	18 +64.6'	21.1' R	A	A	22'	29"	
SL- 14	19 +19.4'	20.8' L	A	A	22'	29"	
SL- 15	19 +75.6'	21.0' R	A	A	22'	29"	
SL- 16	20 +30.4'	20.8' L	A	A	22'	29"	

**LEGEND**

- STREET LIGHTING AND ELECTRICAL CONDUIT
- [H] SL HH#x = STREET LIGHTING HANDHOLE
- ☉ TYPE A STREET LIGHT
- TYPE B STREET LIGHT
- BURIED CONDUIT SWEEP WITH CAP FOR FUTURE USE

SCALE IN FEET

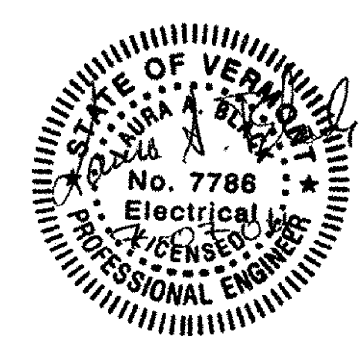

**STREET LIGHTING LAYOUT PLANS**

**SHEET SL2**

SURVEYED BY	CLD	DATE	07/89
DRAWN BY	MLC/JTM/PBH	DATE	06/03
DESIGN BY	LAB/MLC		
DESIGN FILE NO.		JUL 30 2004	
PRF FILE		DATE PLOTTED	
PROJ. NAME	BURLINGTON		
PROJ. NO.	MEGC 5000(15)		
SHEET 103	OF 252	SHEETS	