
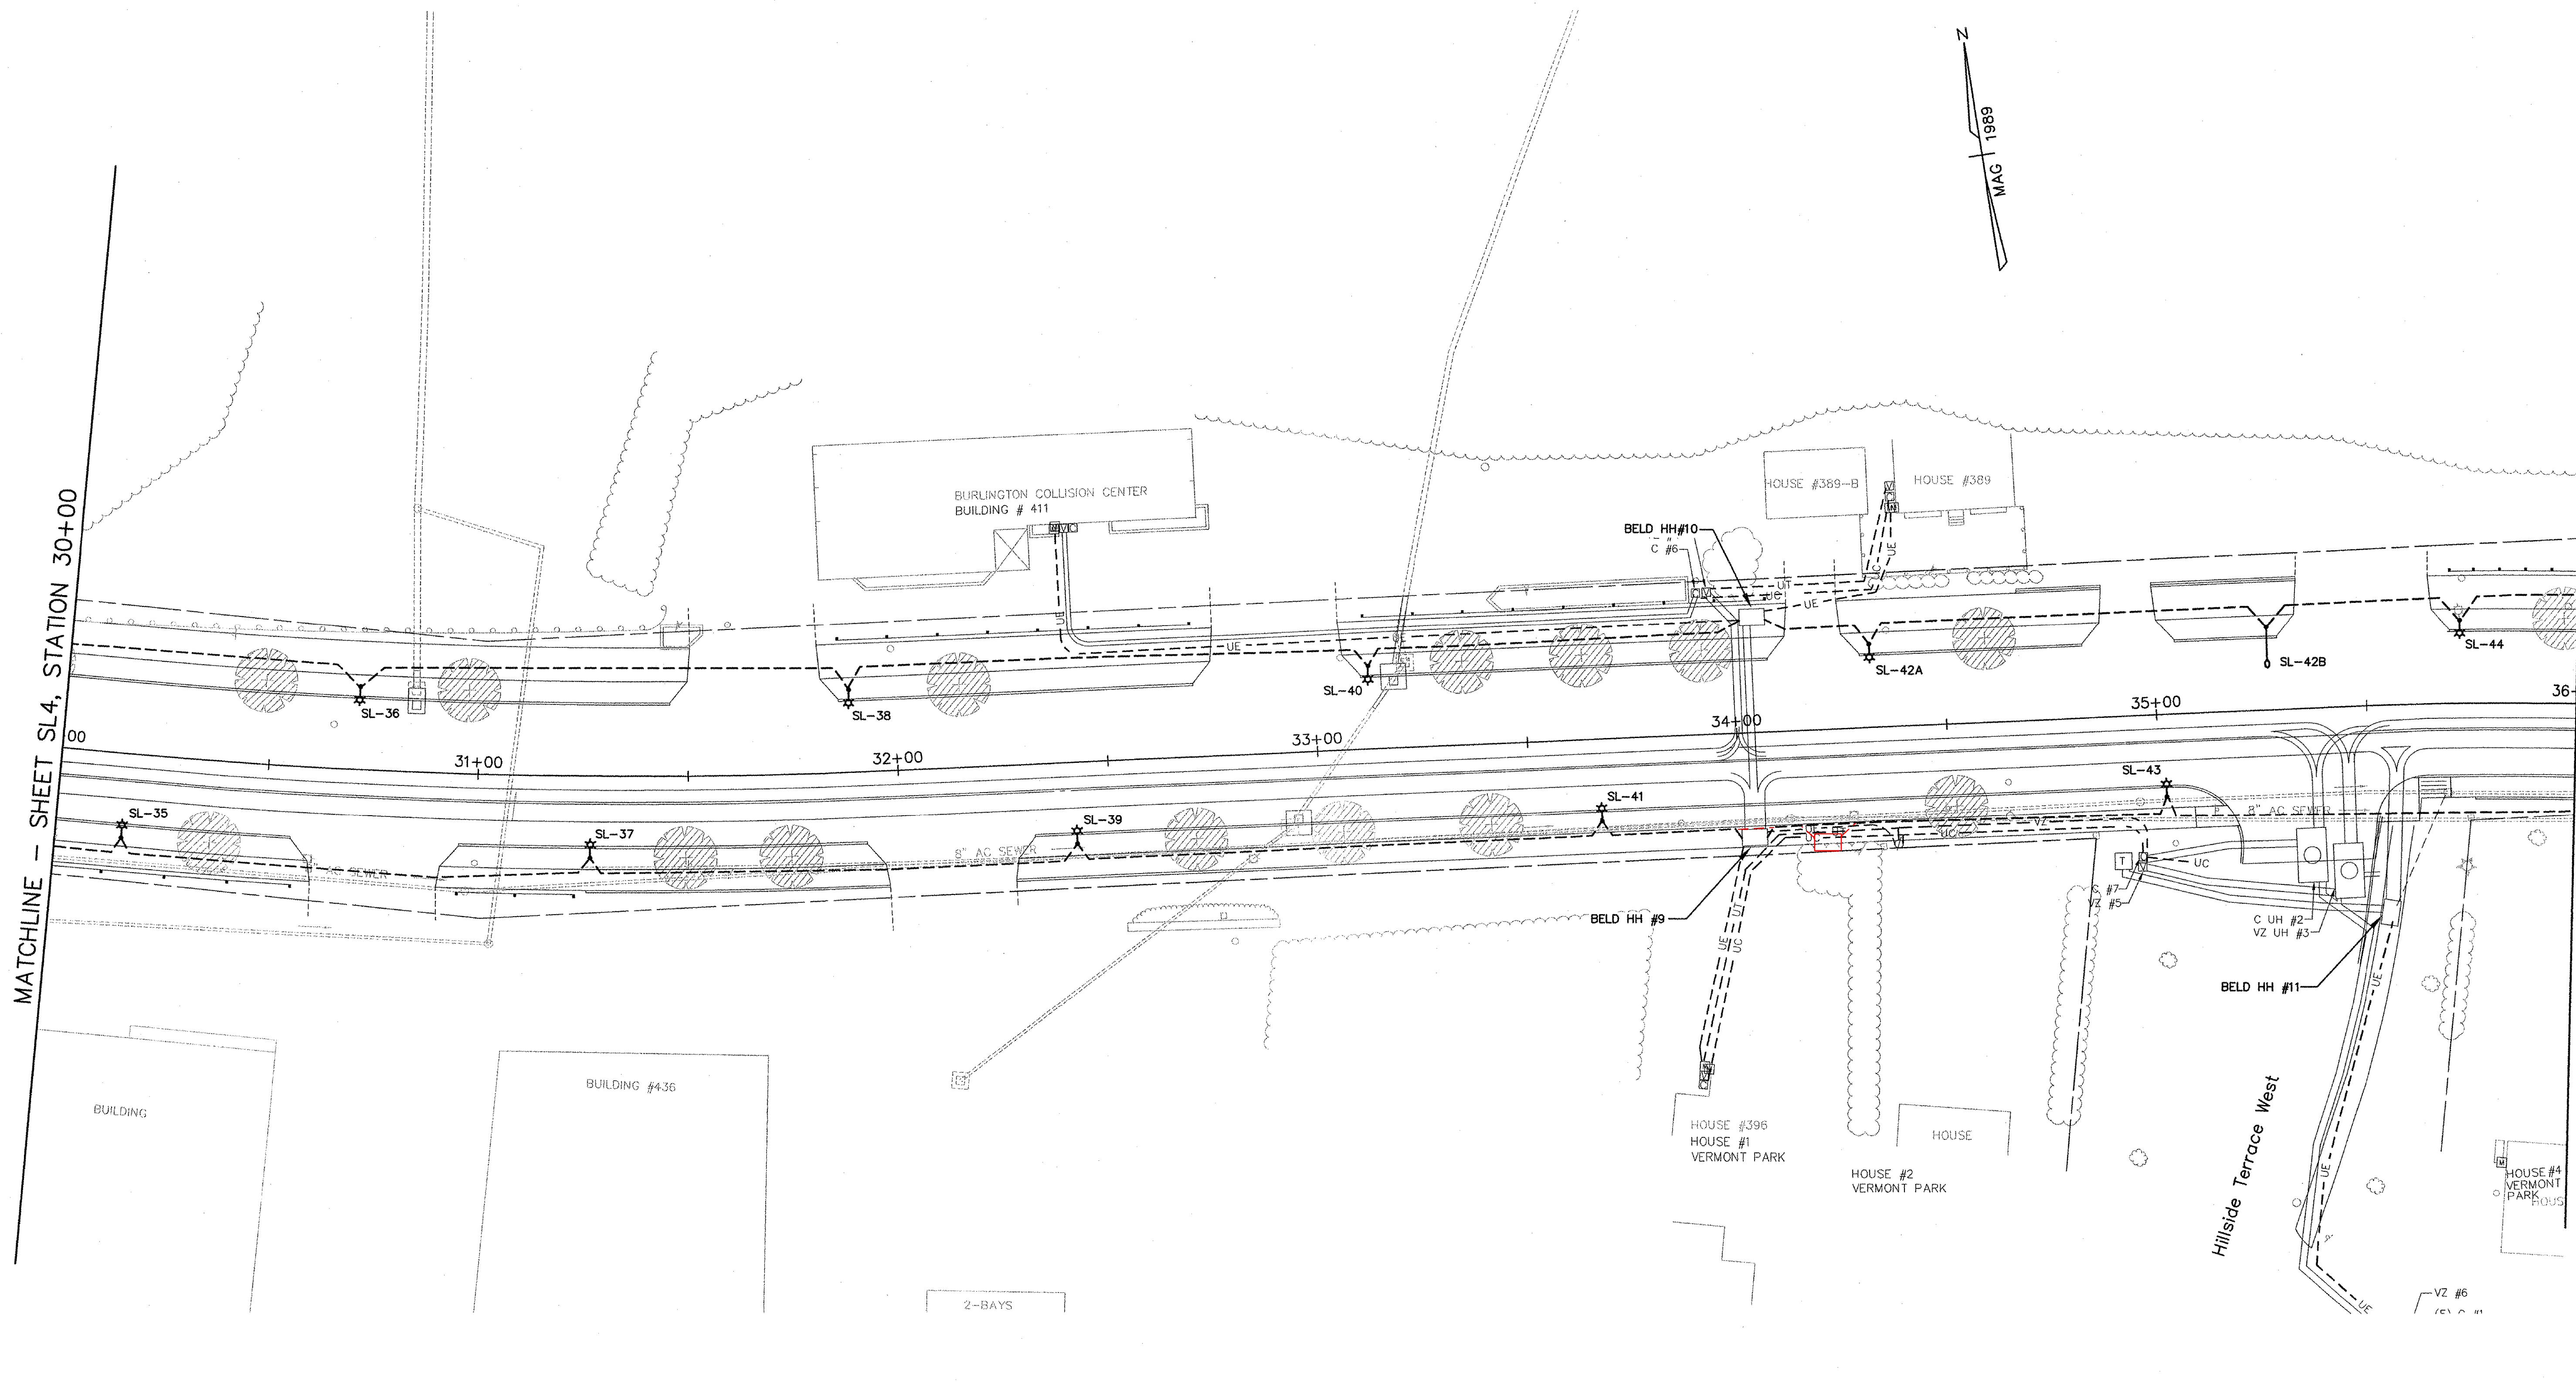


MATCHLINE - SHEET SL4, STATION 30+00

MATCHLINE - SHEET SL6, STATION 36+00

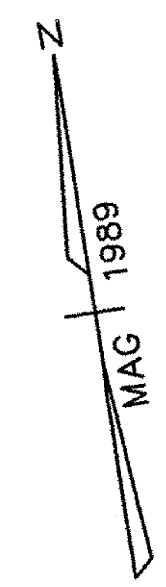

STREET LIGHTING LOCATIONS SCHEDULE							
STREET LIGHT NO.	POLE LOCATION	POLE OFFSET	LUMINAIRE TYPE	POLE TYPE	LUMINAIRE MOUNTING HEIGHT	BRACKET ARM LENGTH	REMARKS
SL- 35	30 +16.4'	20.1' R	A	A	22'	29"	
SL- 36	30 +71.0'	19.8' L	A	A	22'	29"	
SL- 37	31 +26.8'	19.8' R	A	A	22'	29"	
SL- 38	31 +89.0'	19.8' L	A	A	22'	29"	
SL- 39	32 +41.9'	19.8' R	A	A	22'	29"	
SL- 40	33 +12.9'	19.8' L	A	A	22'	29"	
SL- 41	33 +67.0'	19.8' R	A	A	22'	29"	
SL- 42A	34 +32.4'	19.8' L	A	A	22'	29"	
SL- 42B	35 +27.0'	19.8' L	B1	B1	30'	8"	
SL- 43	35 +01.6'	19.8' R	A	A	22'	29"	
SL- 44	35 +37.9'	19.8' L	A	A	22'	29"	

LEGEND

- STREET LIGHTING AND ELECTRICAL CONDUIT
- [H] SL HH#X = STREET LIGHTING HANDHOLE
- ☼ TYPE A STREET LIGHT
- TYPE B STREET LIGHT
- BURIED CONDUIT SWEEP WITH CAP FOR FUTURE USE

STATE OF VERMONT
Professional Engineer
No. 7788
ELECTRICAL
LICENSED

SCALE IN FEET
0 20

STREET LIGHTING LAYOUT PLANS

SHEET SL5

SURVEYED BY CLD DATE 07/89
 DRAWN BY MLC/JTM/PBH DATE 06/03
 DESIGN BY LAB/MLC
 DESIGN FILE NO. JUN. 30 2004
 PRF FILE - DATE PLOTTED -
 PROJ. NAME BURLINGTON
 PROJ. NO. MEGC 5000(15)
 SHEET 106 OF 252 SHEETS

DATUM	NATIONAL GEODETIC
VERTICAL	VERTICAL DATUM 1929
HORIZONTAL	N/A