


MATCHLINE - SHEET SL7, STATION 41+50

MATCHLINE - SHEET SL8, STATION 47+50

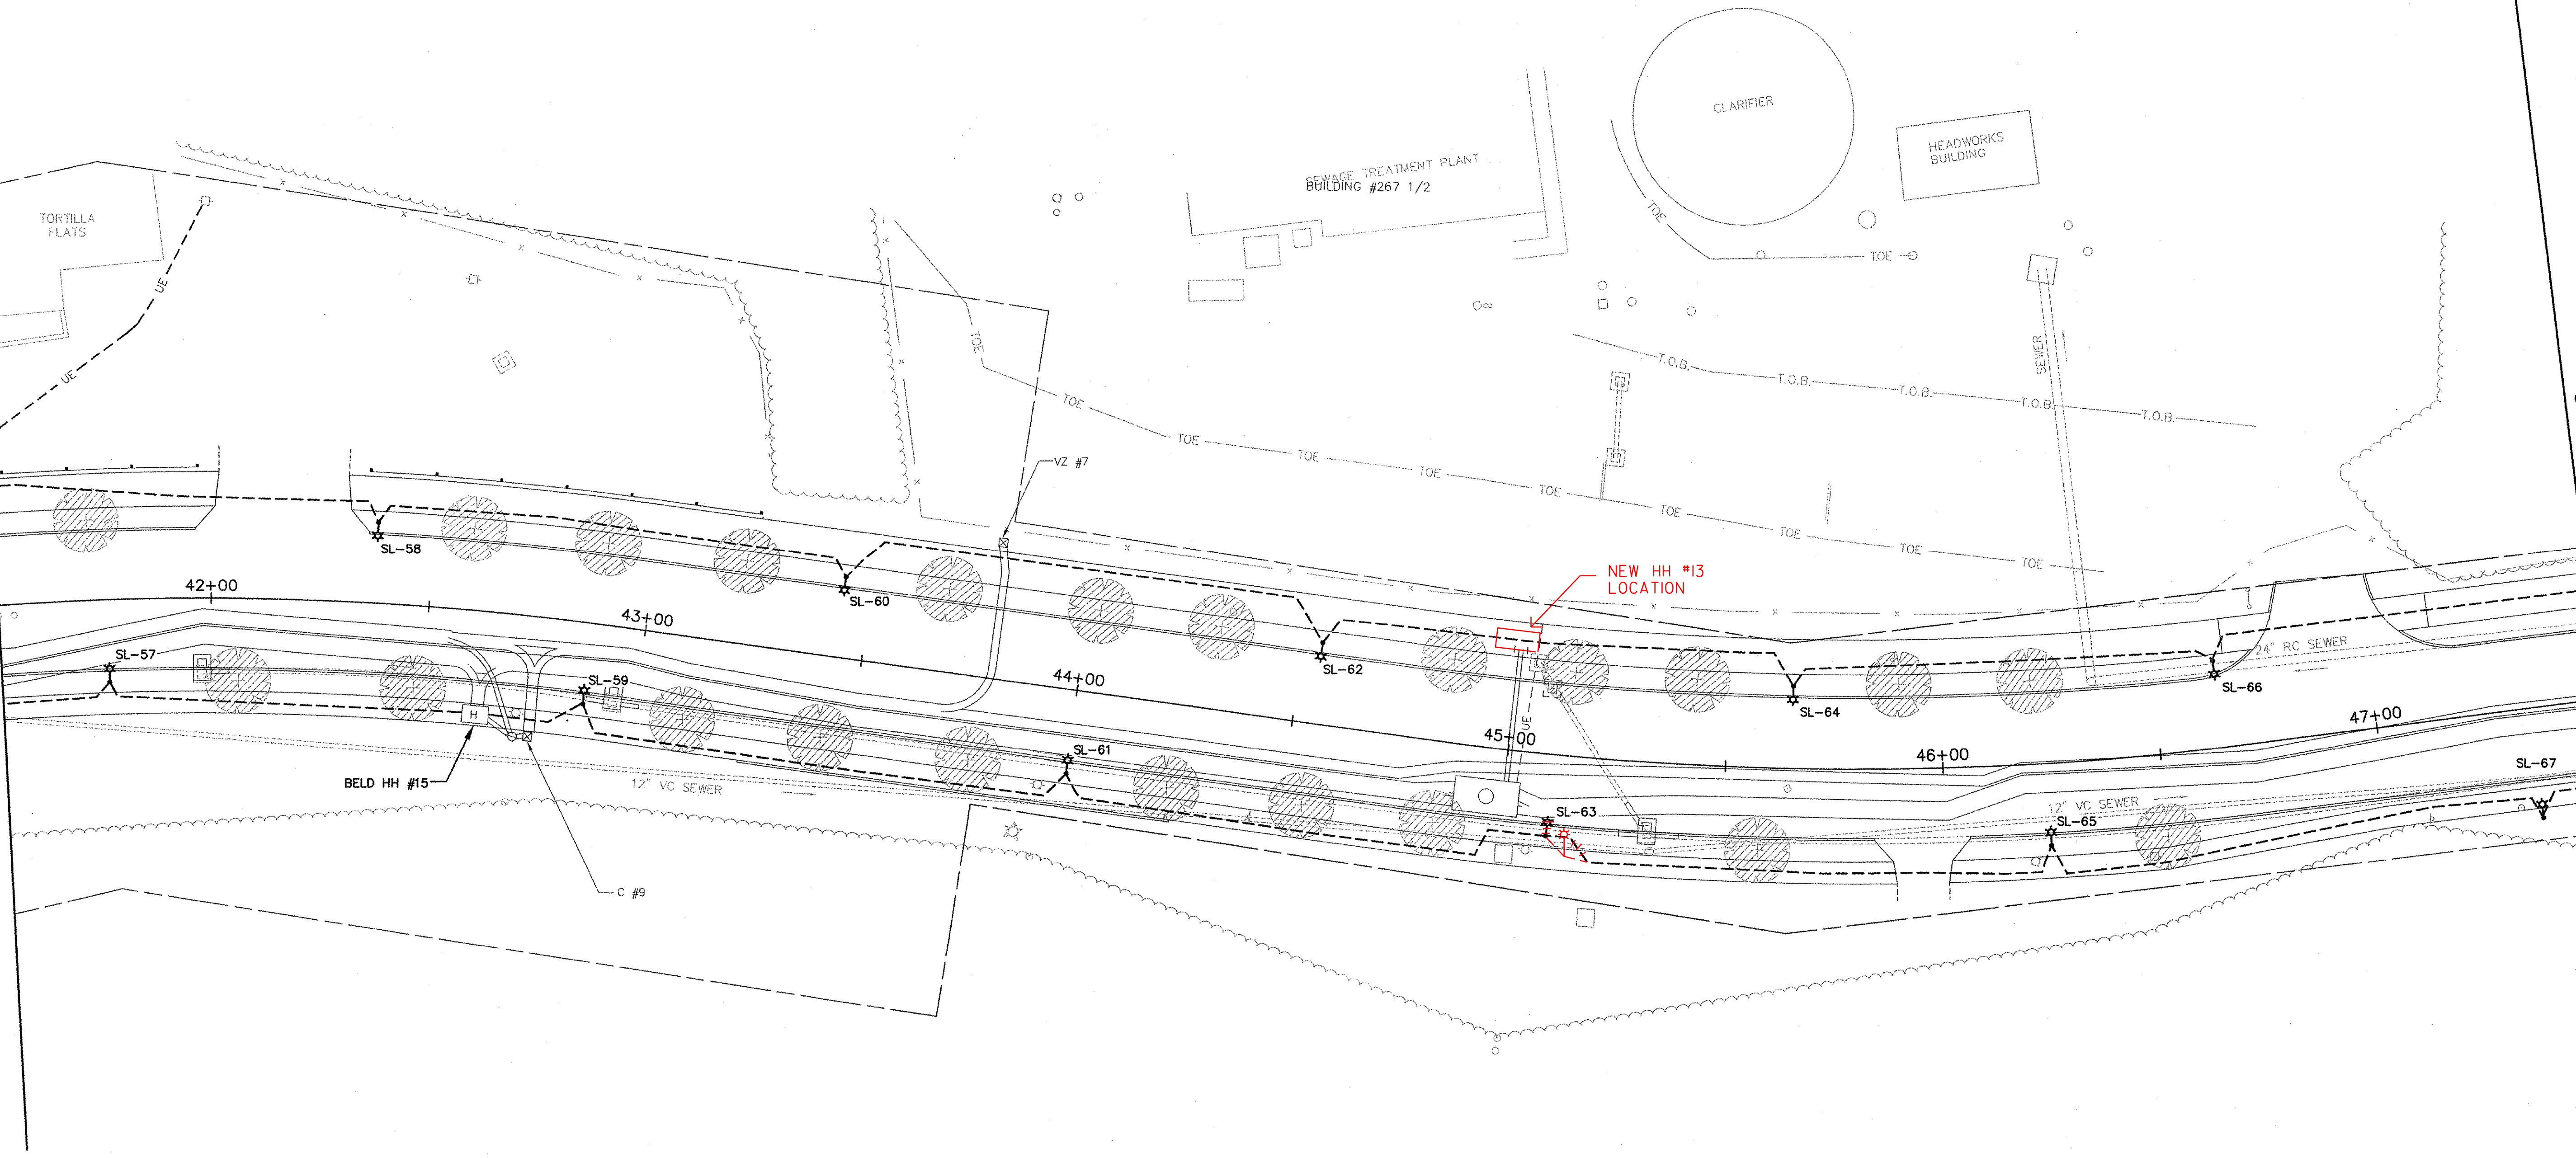

| STREET LIGHTING LOCATIONS SCHEDULE | | | | | | | |
|------------------------------------|---------------|-------------|----------------|-----------|---------------------------|--------------------|---------|
| STREET LIGHT NO. | POLE LOCATION | POLE OFFSET | LUMINAIRE TYPE | POLE TYPE | LUMINAIRE MOUNTING HEIGHT | BRACKET ARM LENGTH | REMARKS |
| SL- 57 | 41 +78.2' | 19.0' R | 19.3' R A | A | 22' | 29" | |
| SL- 58 | 42 +37.4' | 18.9' L | A | A | 22' | 29" | |
| SL- 59 | 42 +88.0' | 18.8' R | A | A | 22' | 29" | |
| SL- 60 | 43 +43.9' | 18.8' L | A | A | 22' | 29" | |
| SL- 61 | 44 +0.1' | 19.1' R | A | A | 22' | 29" | |
| SL- 62 | 44 +54.4' | 18.8' L | A | A | 22' | 29" | |
| SL- 63 | 45 +10.3' | 18.8' R | 20.2' R A | A | 22' | 29" | |
| SL- 64 | 45 +65.3' | 18.8' L | A | A | 22' | 29" | |
| SL- 65 | 46 +23.7' | 19.0' R | 19.9' R A | A | 22' | 29" | |
| SL- 66 | 46 +64.3' | 20.4' L | A | A | 22' | 29" | |
| SL- 67 | 47 +35.3' | 25.3' R | A | A | 22' | 29" | |

DATUM NATIONAL GEODETIC
VERTICAL VERTICAL DATUM 1929
HORIZONTAL N/A

LEGEND

- STREET LIGHTING AND ELECTRICAL CONDUIT
- SL HH#x = STREET LIGHTING HANDHOLE
- TYPE A STREET LIGHT
- TYPE B STREET LIGHT
- BURIED CONDUIT SWEEP WITH CAP FOR FUTURE USE

SCALE IN FEET
0 20

SHEET SL7

SURVEYED BY CLD DATE 07/89
DRAWN BY MLC/JTM/PBH DATE 06/03
DESIGN BY LAB/MLC

DESIGN FILE NO. _____ DATE PLOTTED _____
PRF FILE _____

PROJ. NAME BURLINGTON
PROJ. NO. MEGC 5000(15)
SHEET 108 OF 252 SHEETS

STREET LIGHTING LAYOUT PLANS