


CONDUIT & CONDUCTOR SCHEDULE		
KEY	CONDUIT SIZE	CONDUCTORS
A	2"	3#2, 1#2G
B	2"	2#2, 1#2G
C	2"	3#8, 1#8G
D	2"	2#8, 1#4G
E	2"	EMPTY CONDUIT
F	3"	3#2/0, 1#2G
SEE UNDERGROUND UTILITY DRAWING		

- GENERAL NOTES:**
- ALL CONDUITS SHALL BE TYPE PVC, SCHEDULE 40.
 - MAXIMUM OF 270° IN TOTAL BENDS PERMITTED IN SINGLE RUN OF CONDUIT.
 - STREET LIGHTS SHALL BE FUSED AT BASE WITH Y-TYPE FUSE KIT (EQUAL TO HOMAC [FLOOD SEAL] FYC-6 AND 10 AMP FUSE).
 - CIRCUIT CONDUCTORS INCLUDING NEUTRAL CONDUCTOR SHALL BE CLEARLY IDENTIFIED BY CORROSION RESISTANT TAGS INDICATING CIRCUIT NUMBER AND SOURCE AT EVERY POLE BASE, JUNCTION BOX, HANDHOLE, AND TRANSFORMER.
 - BELD SHALL MAKE ALL CONNECTIONS AT BELD HAND HOLES, AND UTILITY POLES.
 - THE CONTRACTOR SHALL PROVIDE 24" CABLE SLACK AT ALL CONNECTION POINTS, UNLESS OTHERWISE NOTED.
 - ALL CONDUCTOR CONNECTIONS IN HAND HOLES SHALL BE MADE BY BELD, WITH INSULATED WATER PROOF MECHANICAL SCREW-TYPE CONNECTORS. NO BARE OR COMPRESSION TYPE CONNECTORS MAY BE USED.
 - HORIZONTAL 90° CONDUIT BENDS SHALL HAVE A MINIMUM RADIUS OF 36".
 - UTILITY SHALL MAINTAIN 120VAC AT THE RESPECTIVE HANDHOLES WHEN THE CIRCUITS ARE FULLY LOADED.
 - TYPE A STREETLIGHTS INPUT WATTS: 300W
TYPE B STREETLIGHTS INPUT WATTS: 300W

- PARTIAL LEGEND**
- ☒ TRAFFIC CONTROLLER. PROVIDED BY TRAFFIC SIGNAL CONTRACTOR
 - SL-56 — STREETLIGHT ID NO.
 - TYPE 'A' STREET LIGHTS
 - #17b — #XX a,b,c,d INDICATES CIRCUIT NUMBER
 - ☐ BELD H.H. #XX
 - ☐ SL HH#X
 - ☐ STREET LIGHTING HANDHOLE
 - FLASHING YELLOW LIGHT, PROVIDED BY CITY OF BURLINGTON.
 - ⎓ KEY INDICATES STREETLIGHTING CONDUIT AND CONDUCTOR
 - 2" CONDUIT SWEEP WITH CAP
 - SL-1B — STREETLIGHT ID NO.
 - TYPE 'B' STREET LIGHTS
 - #3b — #XX a,b,c,d INDICATES CIRCUIT NUMBER

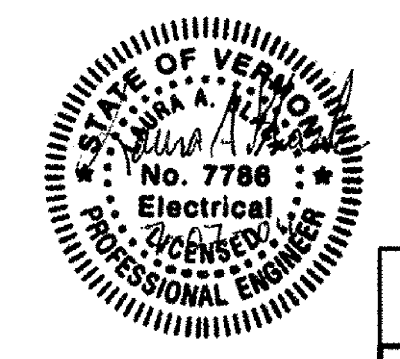

ONE-LINE DIAGRAM

SHEET SL12

SURVEYED BY	CLD	DATE	07/89
DRAWN BY	MLC/PBH	DATE	06/03
DESIGN BY	GAE/LKL/LAB		
DESIGN FILE NO.			
PRF FILE		DATE PLOTTED	
PROJ. NAME	BURLINGTON		
PROJ. NO.	MEGC 5000(15)		
SHEET	113 OF 252	SHEETS	

DATUM	NATIONAL GEODETIC
VERTICAL	VERTICAL DATUM 1929
HORIZONTAL	N/A

ONE LINE DIAGRAM