




-  STRUCTURAL SOIL
-  TOPSOIL

LANDSCAPING PLAN

SURVEYED BY	CLD	DATE	7/89
DRAWN BY	TUS	DATE	10/93
SQUAD LEADER	JAW		
DESIGN FILE NO.	89-108		
IPARM FILE		DATE PLOTTED	
PROJECT NAME:	BURLINGTON		
PROJECT NUMBER:	MEGC 5000(15)		
SHEET 117 OF 252 SHEETS			

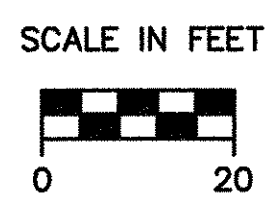

VIEW: CS2

DATUM	
VERTICAL	NGVD 1929
HORIZONTAL	N/A

REV PCC = 16+16.96

REV PT = 19+46.88