


NOTE:
 1. MERGE PLANTING PITS WHERE THERE
 WOULD BE LESS THAN 15' BETWEEN
 SEPARATE PITS.

VIEW: CS7

DATUM	
VERTICAL	NGVD 1929
HORIZONTAL	N/A

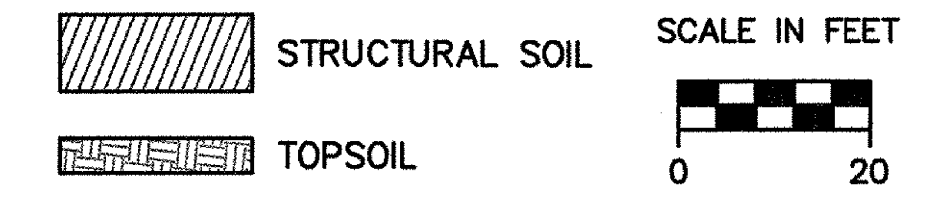

LANDSCAPING PLAN			
SURVEYED BY	CLD	DATE	7/89
DRAWN BY	TUS	DATE	10/93
SQUAD LEADER	JAW		
DESIGN FILE NO.	89-108		
IPARM FILE		DATE PLOTTED	
PROJECT NAME:	BURLINGTON		
PROJECT NUMBER:	MEGC 5000(15)		
SHEET 122 OF 252 SHEETS			