
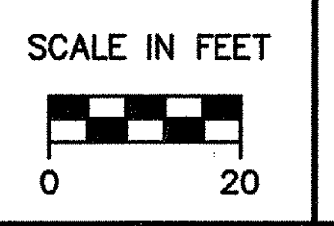


- NOTES:**
1. REFER TO PLANTING AREA DETAILS ON SHEET #129.
  2. MERGE PLANTING PITS WHERE THERE WOULD BE LESS THAN 15' BETWEEN SEPARATE PITS.
  3. PERENNIALS IN VICINITY OF STA 54+00 TO 56+45 SHALL BE INSTALLED ON THE SLOPE BELOW THE NEW RETAINING WALLS.

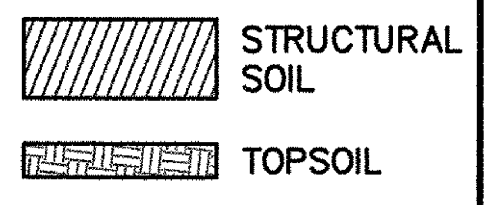

**LANDSCAPING PLAN**

SURVEYED BY	CLD	DATE	7/89
DRAWN BY	TUS	DATE	10/93
SQUAD LEADER	JAW		
DESIGN FILE NO.	89-108		
IPARM FILE		DATE PLOTTED	
PROJECT NAME:	BURLINGTON		
PROJECT NUMBER:	MEGC 5000(15)		
SHEET 124 OF 252 SHEETS			

VIEW: CSS

<b>DATUM</b>	
VERTICAL	NGVD 1929
HORIZONTAL	N/A