


APPROXIMATE AREA OF ANEMONE MULTIFIDA FROM OCT. 20, 1986 MAP BY JENKINS & WARSHAW
DO NOT DISTURB

DO NOT DISTURB
APPROXIMATE AREA OF ANEMONE MULTIFIDA FROM OCT. 20, 1986 MAP BY JENKINS & WARSHAW

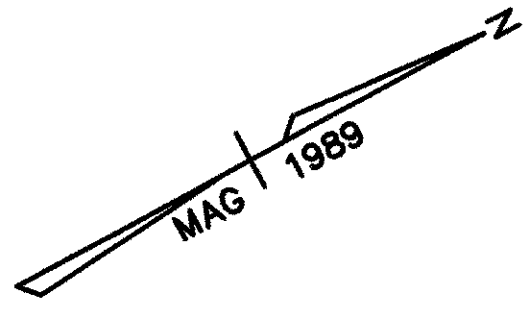

VIEW: GS11

DATUM	
VERTICAL	NGVD 1929
HORIZONTAL	N/A

LANDSCAPING PLAN			
SURVEYED BY	CLD	DATE	7/89
DRAWN BY	TUS	DATE	10/93
SQUAD LEADER	JAW		
DESIGN FILE NO.	89-108		
IPARM FILE	DATE PLOTTED		
PROJECT NAME:	BURLINGTON		
PROJECT NUMBER:	MEGC 5000(15)		
SHEET 126 OF 252 SHEETS			

