

VIEW: CS2
DATUM
 VERTICAL NGVD 1929
 HORIZONTAL N/A


REV PCC = 16+16.96

REV PT = 19+46.88

- DURABLE AND TEMPORARY 4" WHITE LINE (TYPE I TAPE)**
 REV 14+50, 16' RT - 20+50, 16' RT
 REV 14+50, 16' LT - 20+50, 16' LT
 REV 14+50, 5' LT - 16+50, 5' LT
 REV 16+50, 5' LT - 17+50, 5' LT (DOTTED)
 REV 19+00, 5' RT - 20+00, 5' RT (DOTTED)
 REV 20+00, 5' RT - 20+50, 5' RT
 21+87
- DURABLE AND TEMPORARY 4" YELLOW LINE (TYPE I TAPE)**
 REV 14+50, 5' RT - 19+00, 5' RT
 REV 16+50, 5' RT - 17+50, 5' LT
 REV 17+50, 5' LT - 20+50, 5' LT
 REV 19+00, 5' RT - 20+00, 5' LT
 19+93
- LEGEND**
 DDSYL = DURABLE DOUBLE SOLID YELLOW LINE
 DSWL = DURABLE SOLID WHITE LINE
 DDWL = DURABLE DOTTED WHITE LINE
 R&S = REMOVE AND SALVAGE
- DURABLE AND TEMPORARY LETTER OR SYMBOL (TYPE I TAPE)**
 REV 15+21, 3' LT - (ARROW-LT)
 REV 15+34, 0' RT - (ONLY)
 REV 16+38, 3' LT - (ARROW-LT)
 REV 16+50, 0' LT - (ONLY)
 REV 20+00, 0' LT - (ONLY)
 REV 20+17, 4' RT - (ARROW-LT)
- REMOVING SIGNS**
 AS SHOWN 5
- SALVAGED TRAVEL INFORMATION SIGNS**
 AS SHOWN 1
- ERECTING SALVAGED SIGNS**
 AS SHOWN 4
- EXISTING SIGNS OK
 NO WORK DONE

TRAFFIC SIGNING & PAVEMENT MARKING PLAN

SURVEYED BY	CLD	DATE	7/89
DRAWN BY	TUS	DATE	10/83
SQUAD LEADER	JAW		
DESIGN FILE NO.	89-108		
IPARM FILE	DATE PLOTTED		
PROJECT NAME:	BURLINGTON		
PROJECT NUMBER:	MEGC 5000(15)		
SHEET	131 OF 252 SHEETS		

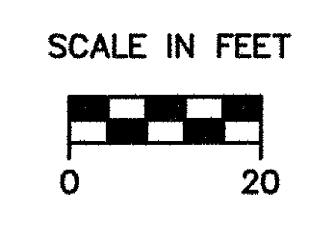

NOTE: ALL TEMPORARY MARKINGS SHALL BE TEMPORARY PAINT.