

**4" YELLOW**  
 45 LF HILLSIDE TERR. WEST  
 DURABLE AND TEMPORARY 4" YELLOW LINE (TYPE I TAPE)  
 REV 30+00, 0' RT - 35+14, 0' RT  
 REV 35+84, 0' RT - 36+00, 0' RT

**6"**  
 DURABLE AND TEMPORARY 6" WHITE LINE (TYPE I TAPE)  
 REV 30+00, 12' RT - 34+94, 12' RT 34+95  
 REV 30+00, 12' LT - 36+00, 12' LT  
 REV 35+74, 12' RT - 36+00, 12' RT

**DURABLE AND TEMPORARY CROSSWALK MARKING W/ DIAGONAL LINES (MOD)(TYPE I TAPE)**  
 REV 35+17 - 35+54 RT

**DURABLE AND TEMPORARY LETTER OR SYMBOL**  
 REV 33+00 RT (BIKE LANE MARKER)  
 REV 33+25 LT (BIKE LANE MARKER)

**REMOVING SIGNS**  
 AS SHOWN 5

**ERECTING SALVAGED SIGNS**  
 AS SHOWN 2


**DURABLE 24" STOPBAR (TYPE I TAPE)**  
 35+35 RT - 35+49 RT (HILLSIDE TERR. WEST)

**LEGEND**  
 DDSYL = DURABLE DOUBLE SOLID YELLOW LINE  
 DSWL = DURABLE SOLID WHITE LINE  
 DDWL = DURABLE DASHED WHITE LINE  
 R&S = REMOVE AND SALVAGE

**NOTE: ALL TEMPORARY MARKINGS SHALL BE TEMPORARY PAINT.**

VIEW: CSS

<b>DATUM</b>	
VERTICAL	NGVD 1929
HORIZONTAL	N/A

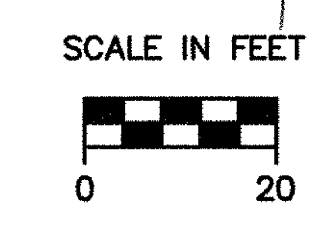

**TRAFFIC SIGNING & PAVEMENT MARKING PLAN**

SURVEYED BY	CLD	DATE	7/89
DRAWN BY	TUS	DATE	10/93
SQUAD LEADER	JAW		
DESIGN FILE NO.	89-108		
IPARM FILE		DATE PLOTTED	
PROJECT NAME:	BURLINGTON		
PROJECT NUMBER:	MEGC 5000(15)		
SHEET 134 OF 252 SHEETS			