



MAST ARM CROSS SECTION AT RIVERSIDE AVE. AND WINOOSKI AVE. INTERSECTION

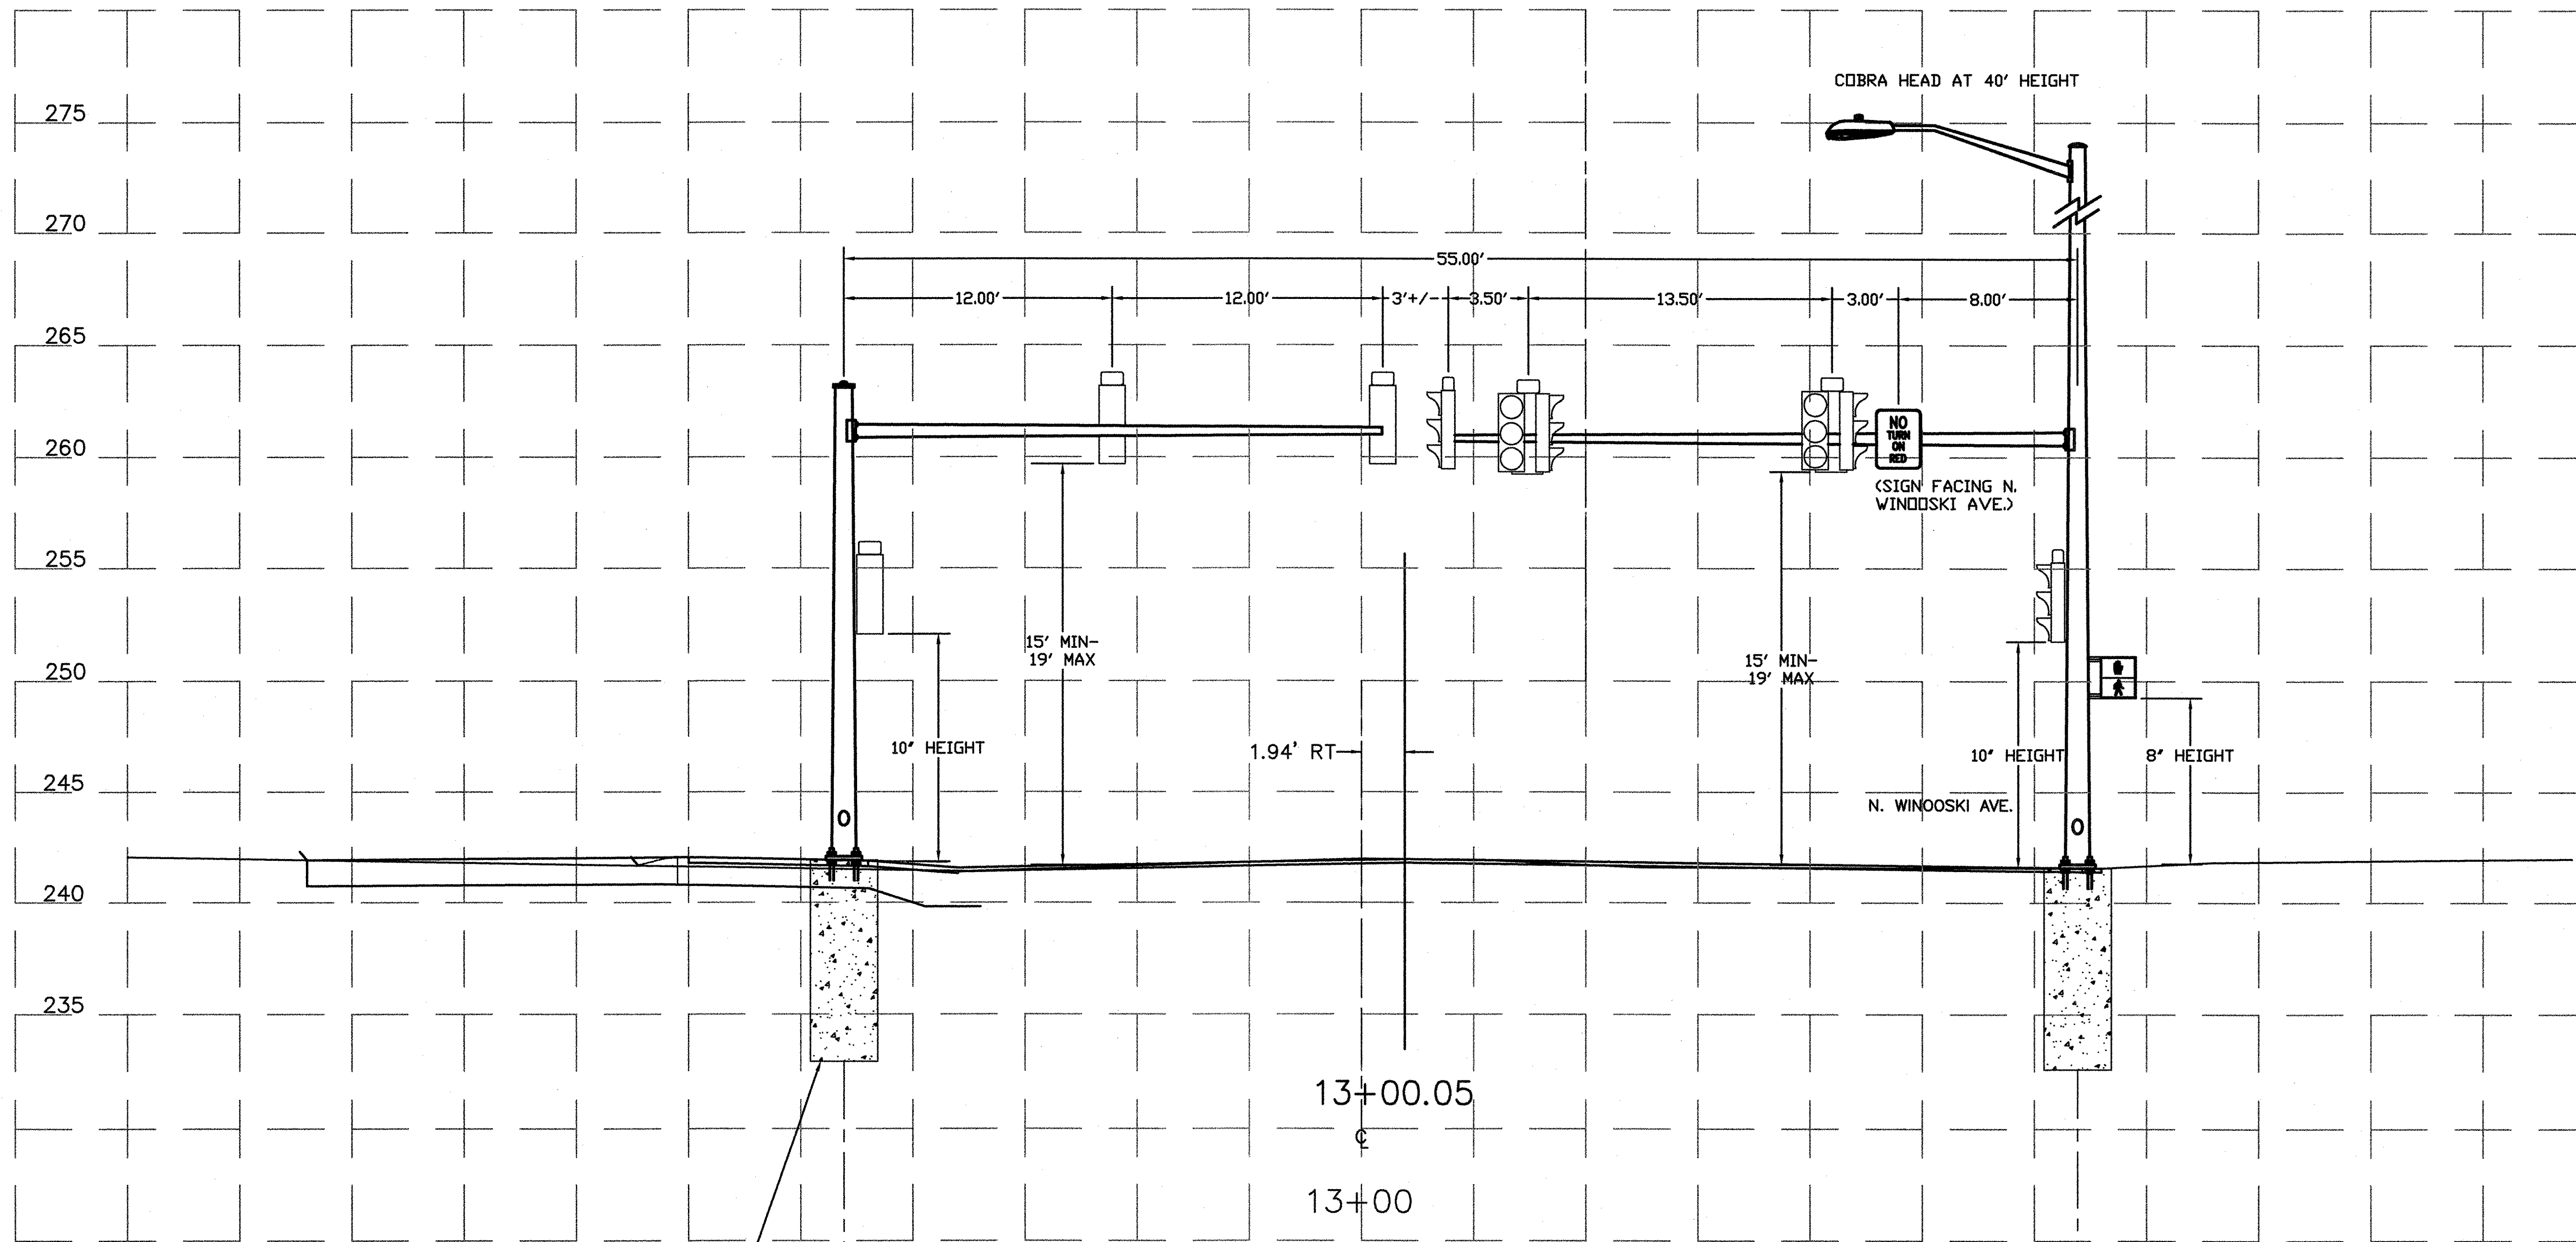

NOTE: FOUNDATION DESIGNS TO BE SUPPLIED BY MANUFACTURER OF SIGNAL POLES

UTILITIES SHALL BE VERIFIED ON CROSS SECTIONS

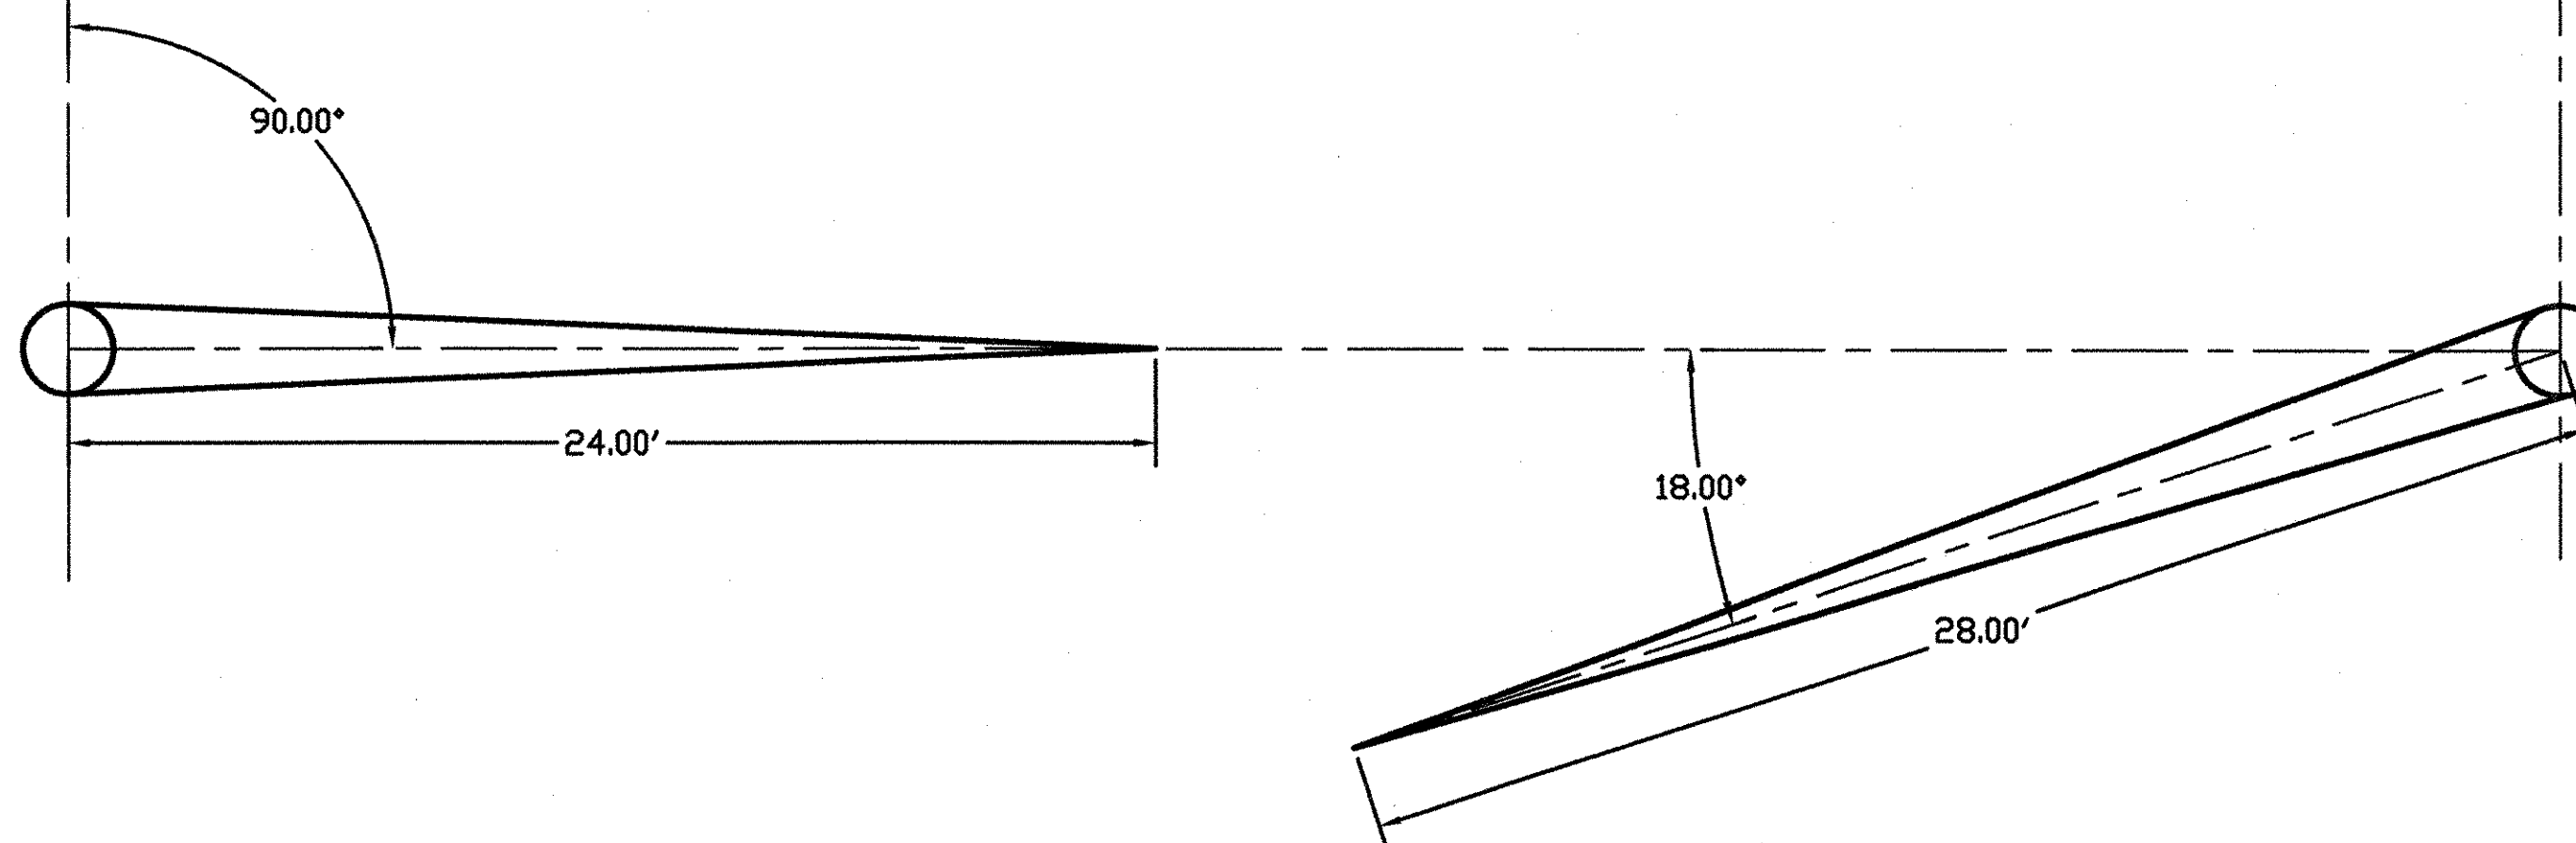

SCALE
VERTICAL 1" = 4'-0"
HORIZONTAL 1" = 4'-0"

MAST ARM CROSS SECTION

SURVEYED BY	JAC	DATE	5/00
DRAWN BY	KRD	DATE	5/00
SQUAD LEADER	KRD		
DESIGN FILE NO.	89108		
PRF FILE	89108	DATE	
		PLOTTED	
PROJ. NAME	BURLINGTON		
PROJ. NO.	MEGC 5000(15)		
SHEET	159	OF	252 SHEETS