



# MAST ARM CROSS SECTION AT RIVERSIDE AVE. AND INTERVALE ROAD INTERSECTION

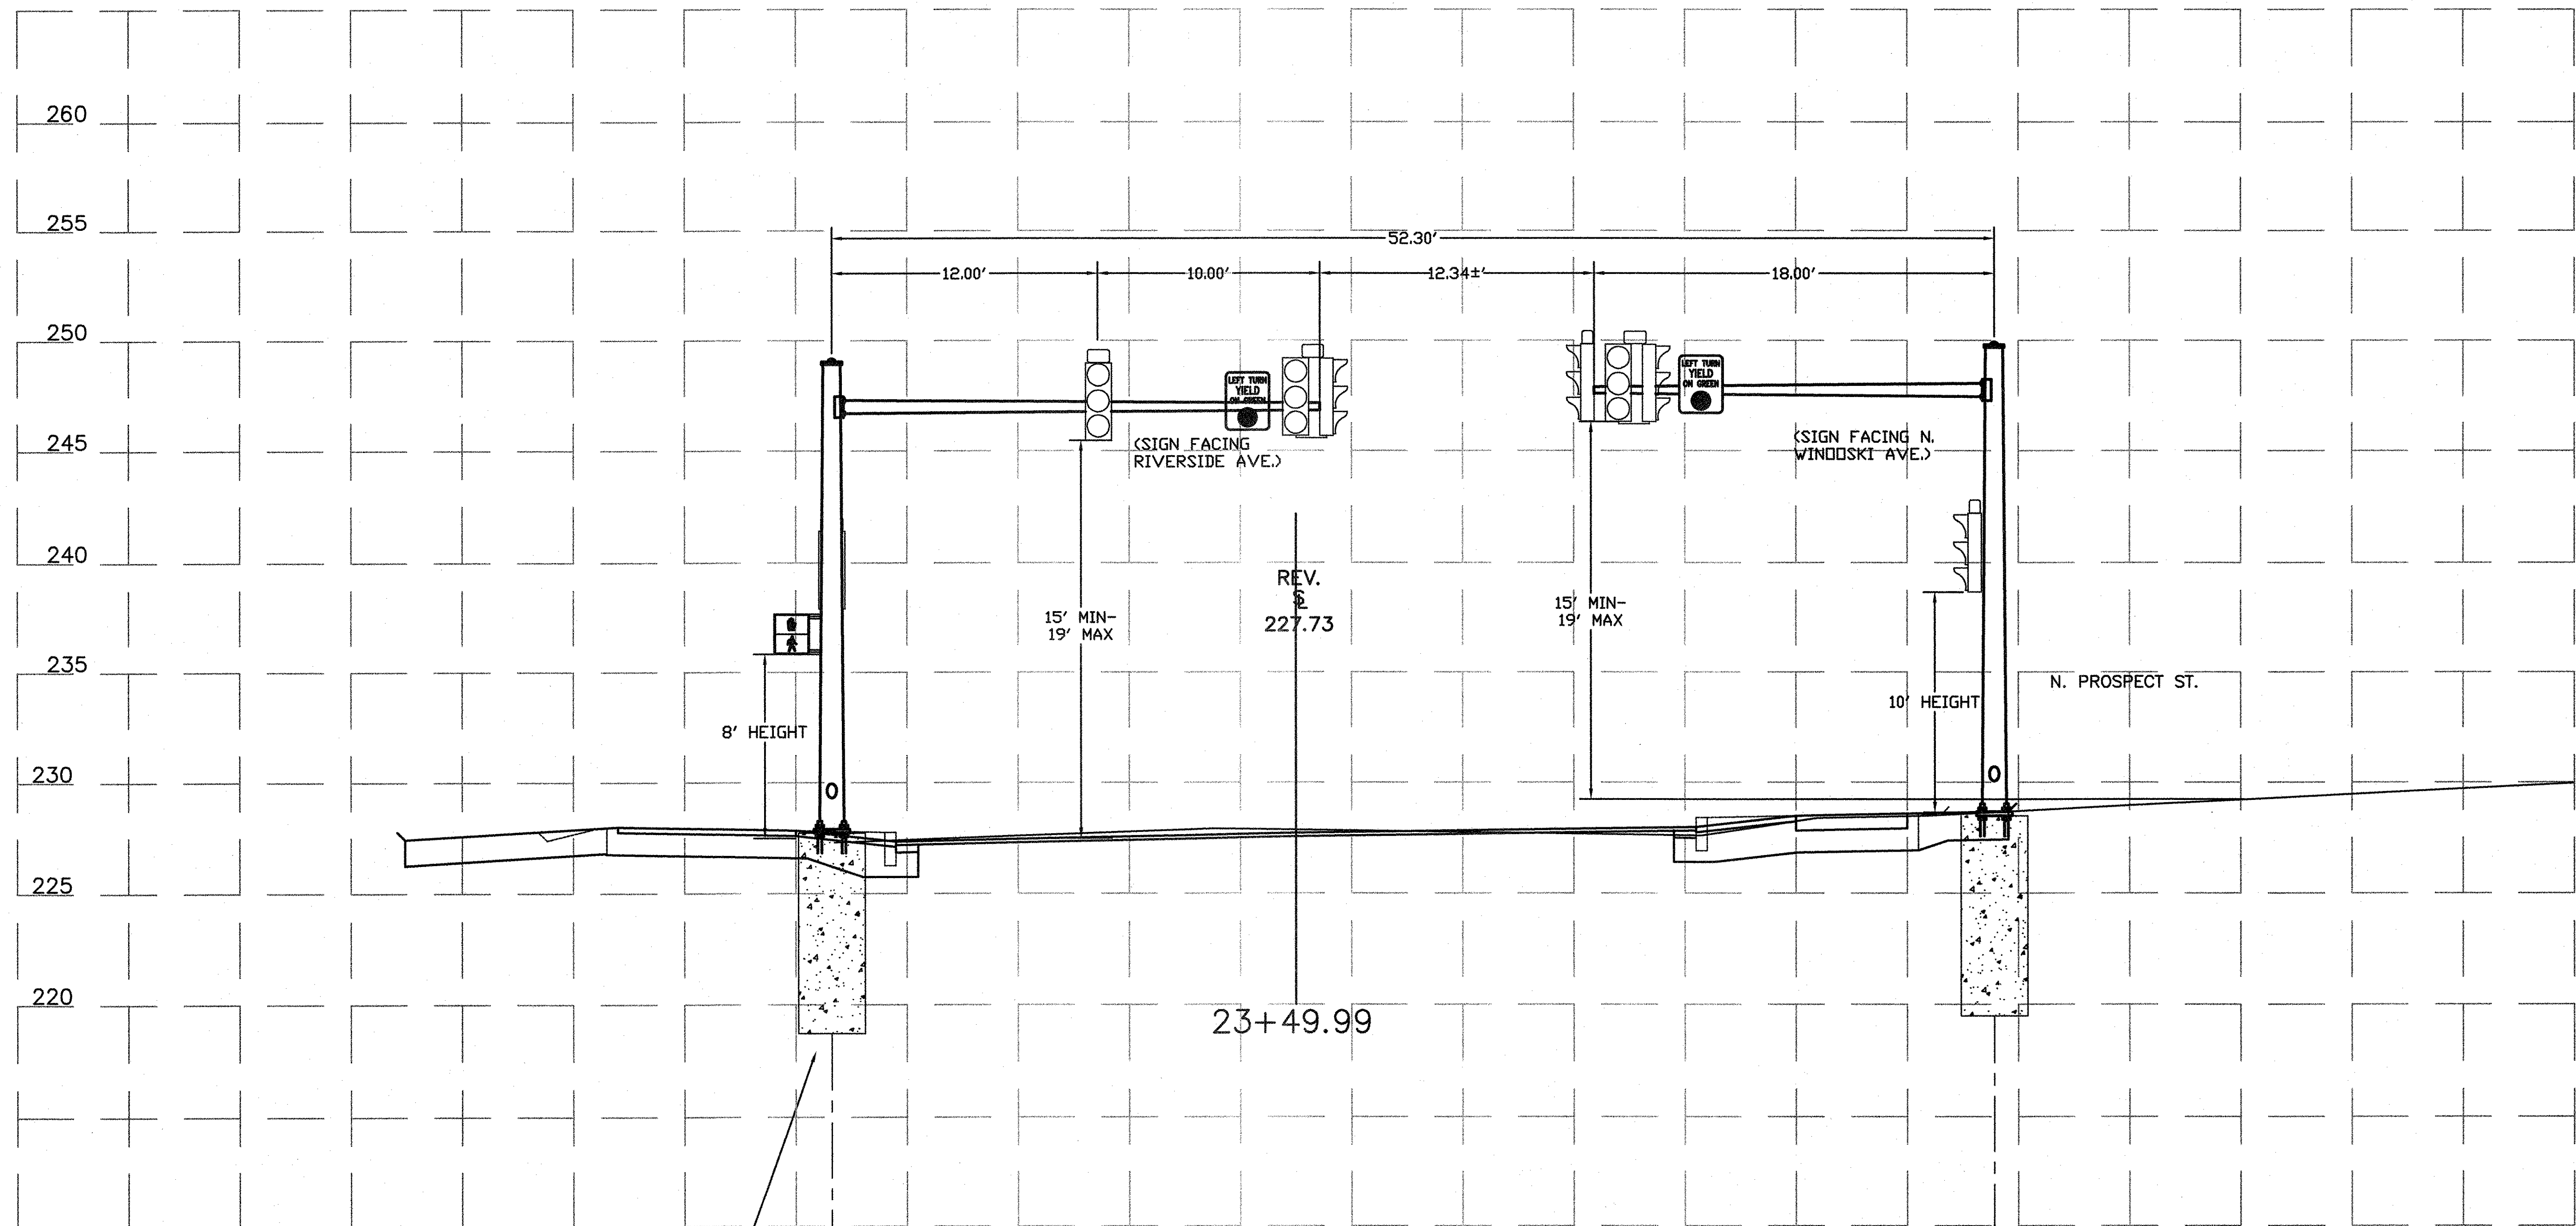

NOTE: FOUNDATION DESIGNS TO BE SUPPLIED BY MANUFACTURER OF SIGNAL POLES

UTILITIES SHALL BE VERIFIED ON CROSS SECTIONS

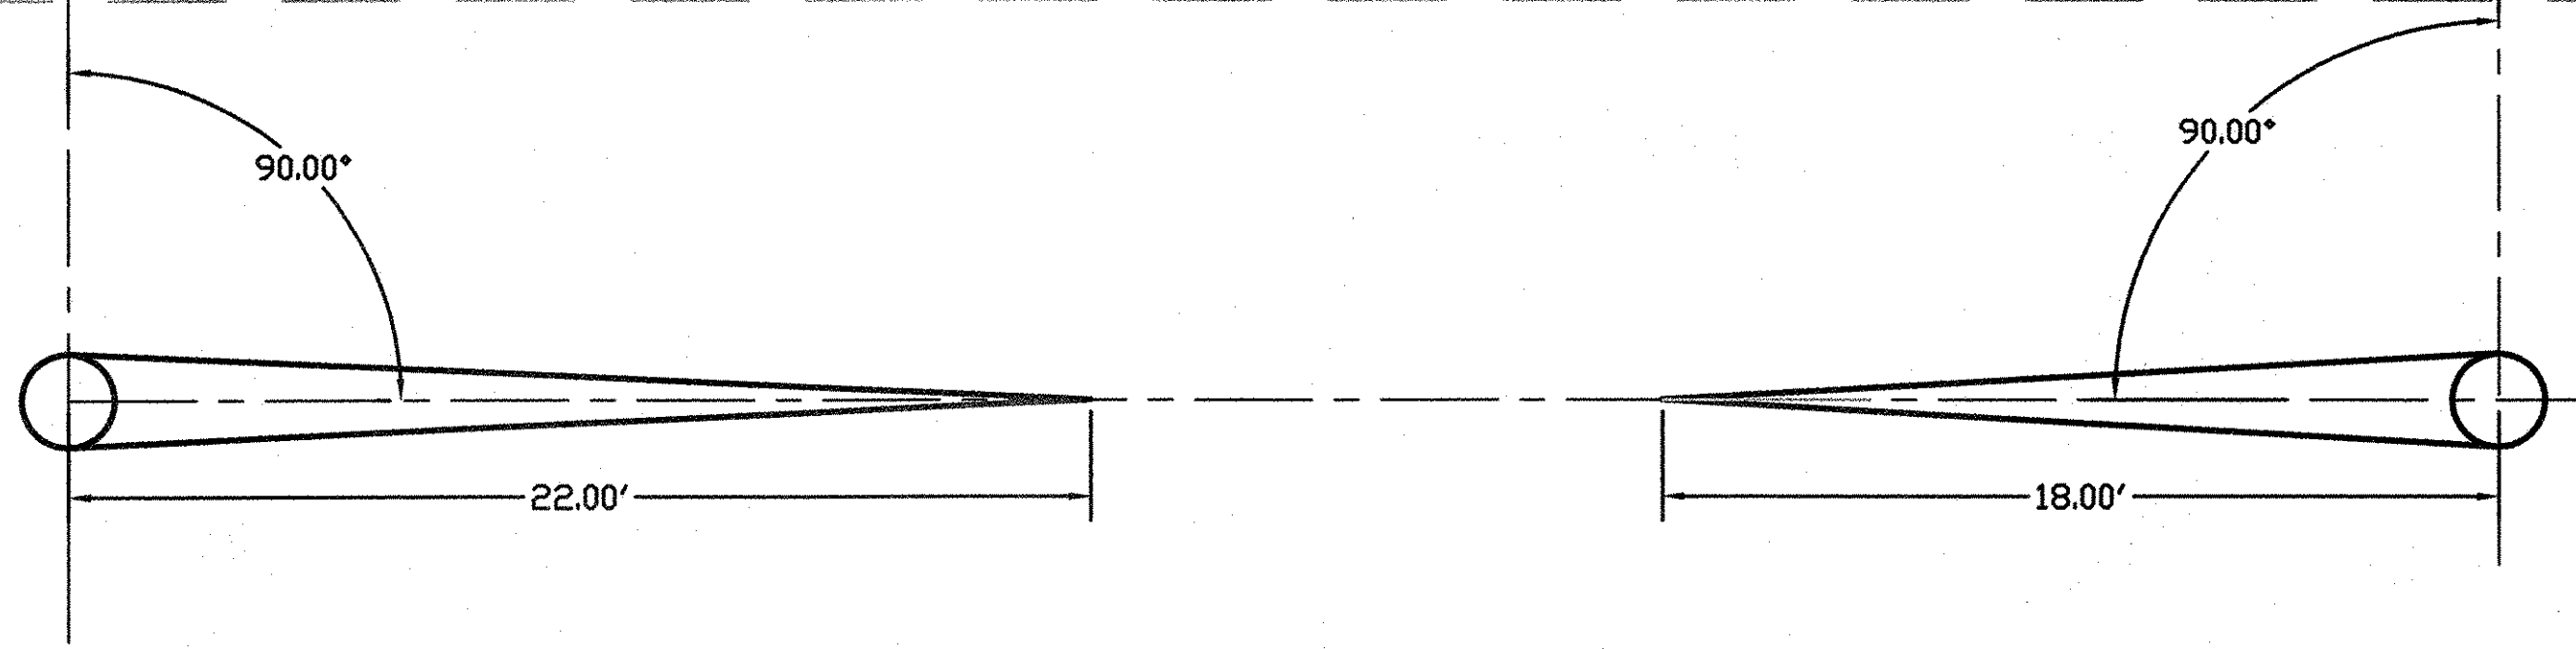

SCALE  
 VERTICAL 1" = 4'-0"  
 HORIZONTAL 1" = 4'-0"

MAST ARM CROSS SECTION	
SURVEYED BY	DATE
DRAWN BY <u>BF</u>	DATE <u>6/03</u>
SQUAD LEADER <u>KRD</u>	
DESIGN FILE NO. <u>89108</u>	
PRF	DATE
FILE <u>89108</u>	PLOTTED
PROJ. NAME <u>BURLINGTON</u>	
PROJ. NO. <u>MEGC 5000(15)</u>	
SHEET <u>160</u> OF <u>252</u> SHEETS	

F:\Pro\80\89108\Hwy2\ACAD\Traffic\cantilvr.dwg 06/11/01 04:20:15 PM PM EDT