


FINAL SURVEY NOTEBOOK NO.	SURVEYED	BY	DATE
	PLOTTED		
	TEMPLATE		
	AREAS		
	AREAS CHECKED		

ORIGINAL	SURVEYED	BY	DATE
NOTEBOOK	PLANTED		
	TEMPLE		
	AREAS		
NO	AREAS CHECKED		

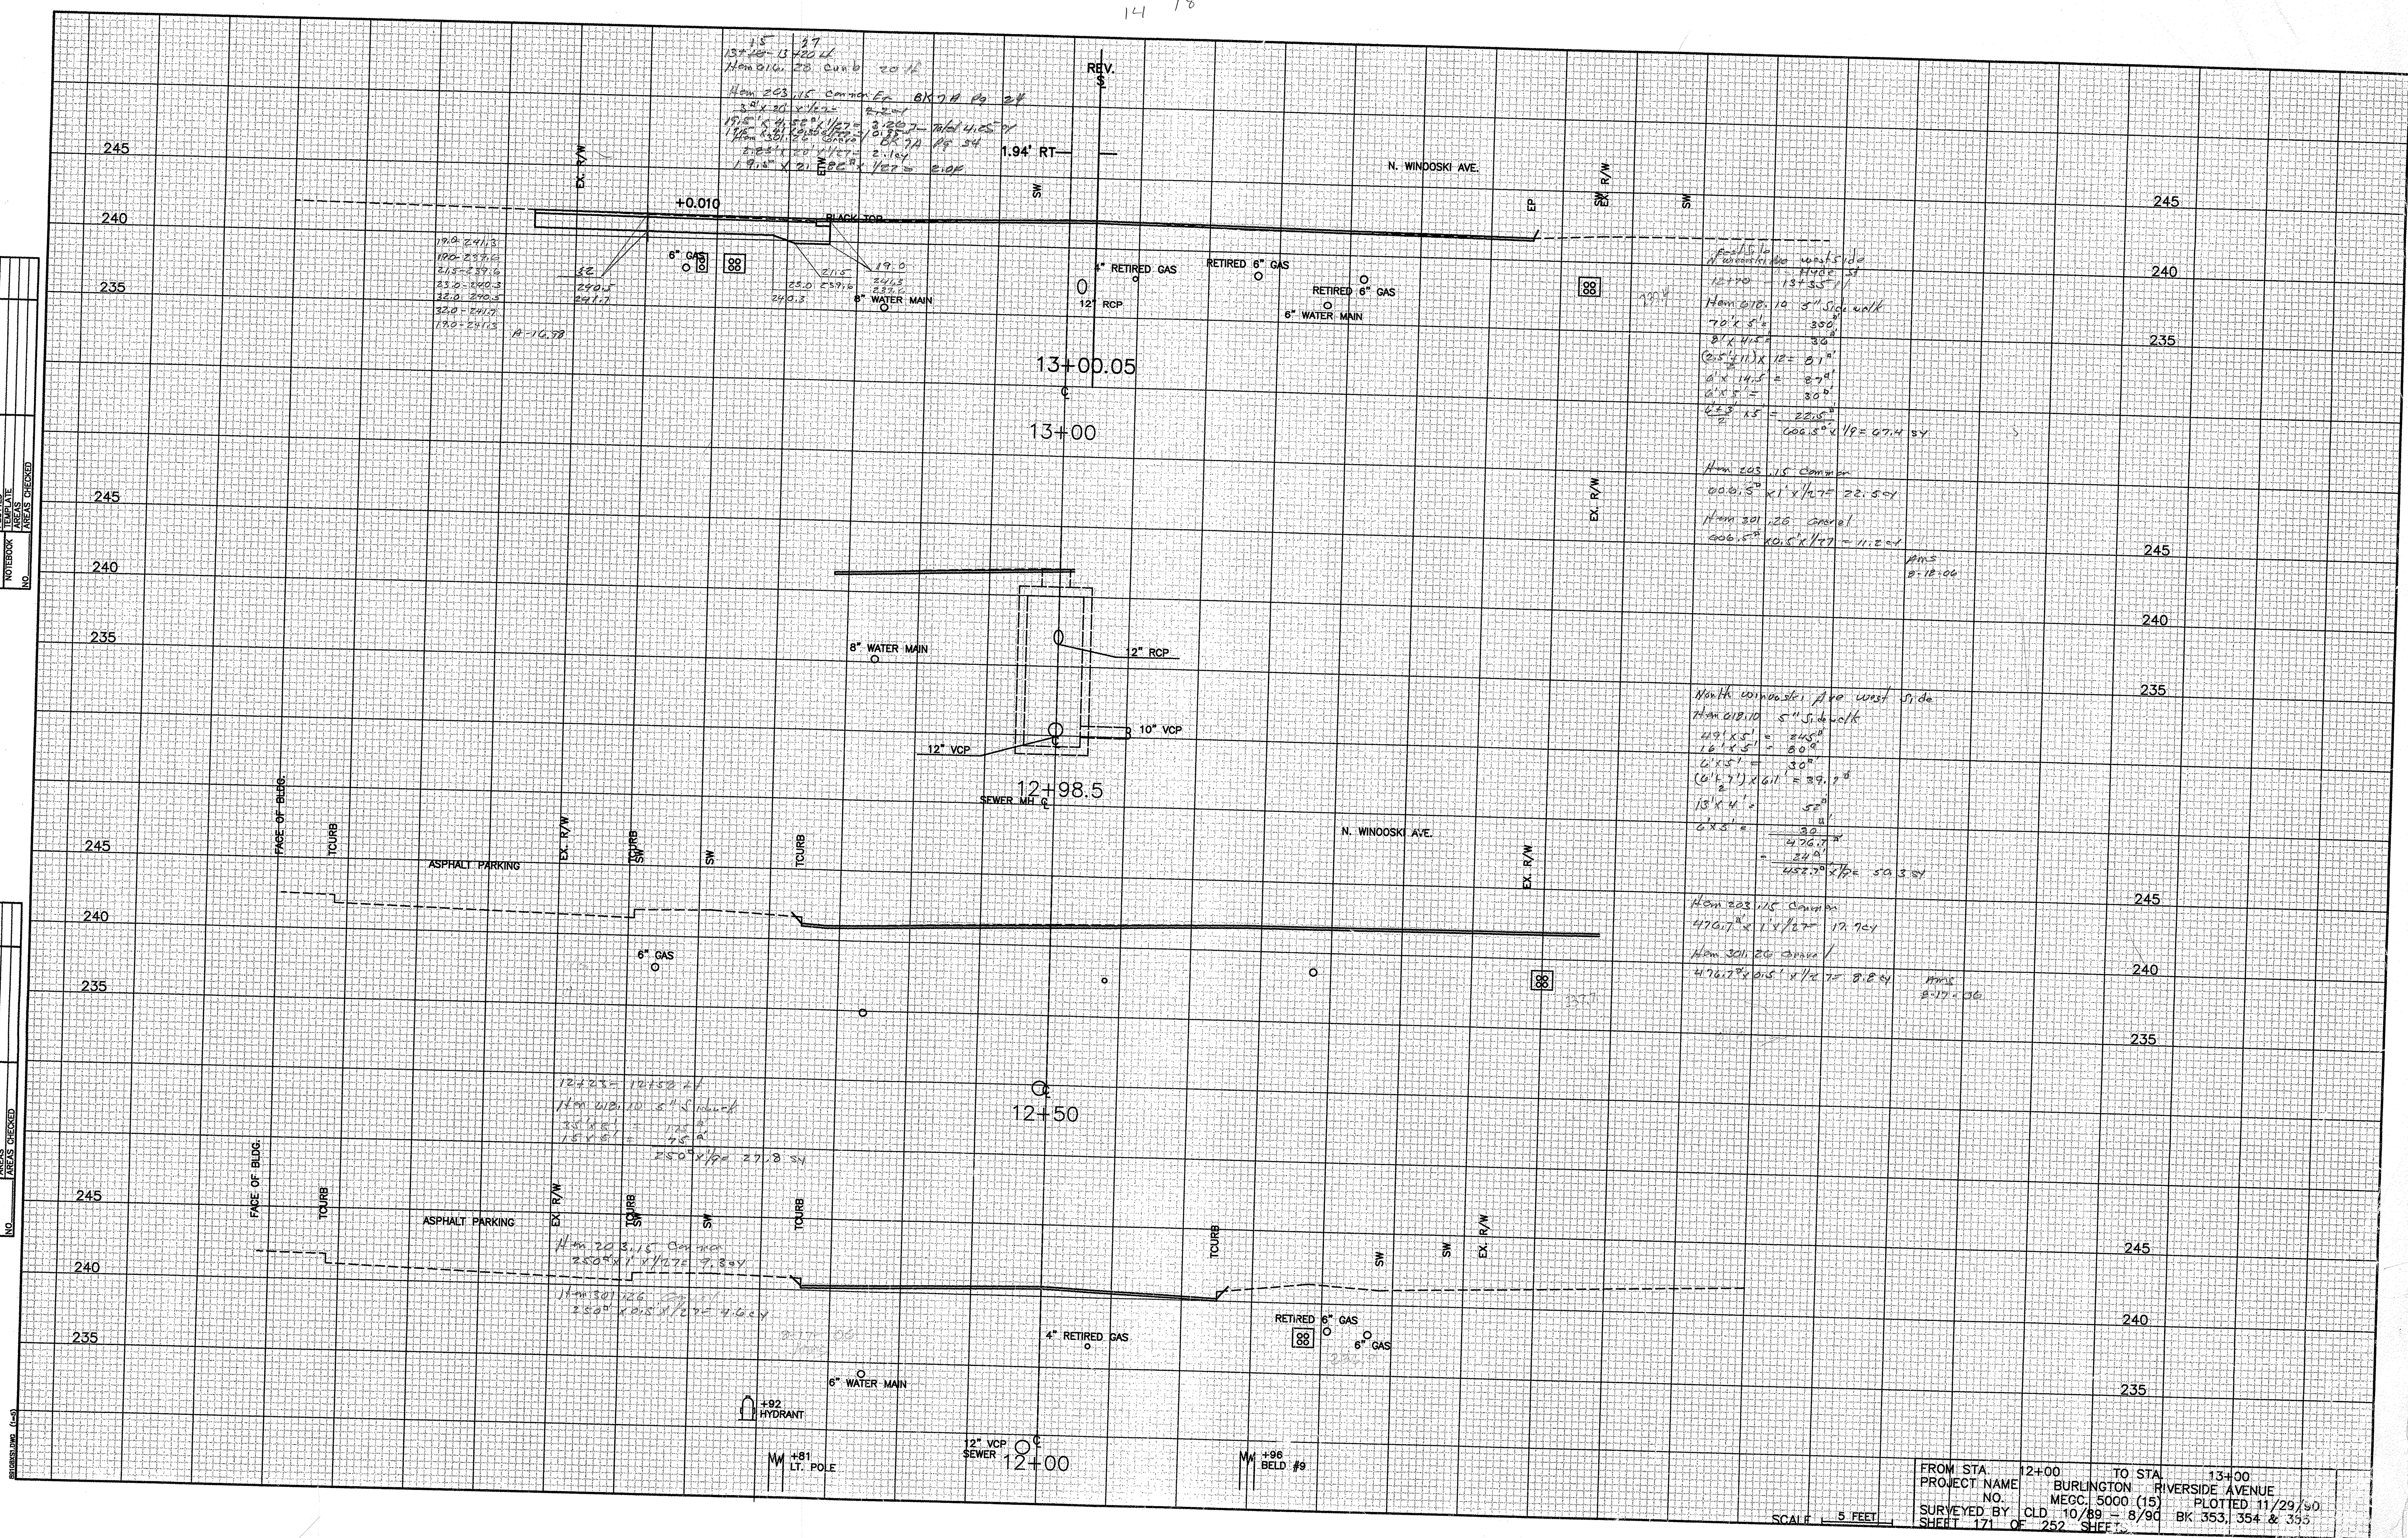

FROM STA.	12+00	TO STA.	13+00
PROJECT NAME	BURLINGTON RIVERSIDE AVENUE		
NO.	MECC. 5000 (15)		
SURVEYED BY	CLD 10/89 = 8/90	PLOTTED 11/29/90	
SHEET 171 OF	252 SHEETS	BK 353, 354 & 355	