


DATE	
BY	
NO.	
FINAL SURVEY	
SURVEYED	
PLOTTED	
TEMPLATE	
NOTEBOOK	
AREAS CHECKED	

DATE	
BY	
NO.	
ORIGINAL SURVEY	
SURVEYED	
PLOTTED	
TEMPLATE	
NOTEBOOK	
AREAS CHECKED	

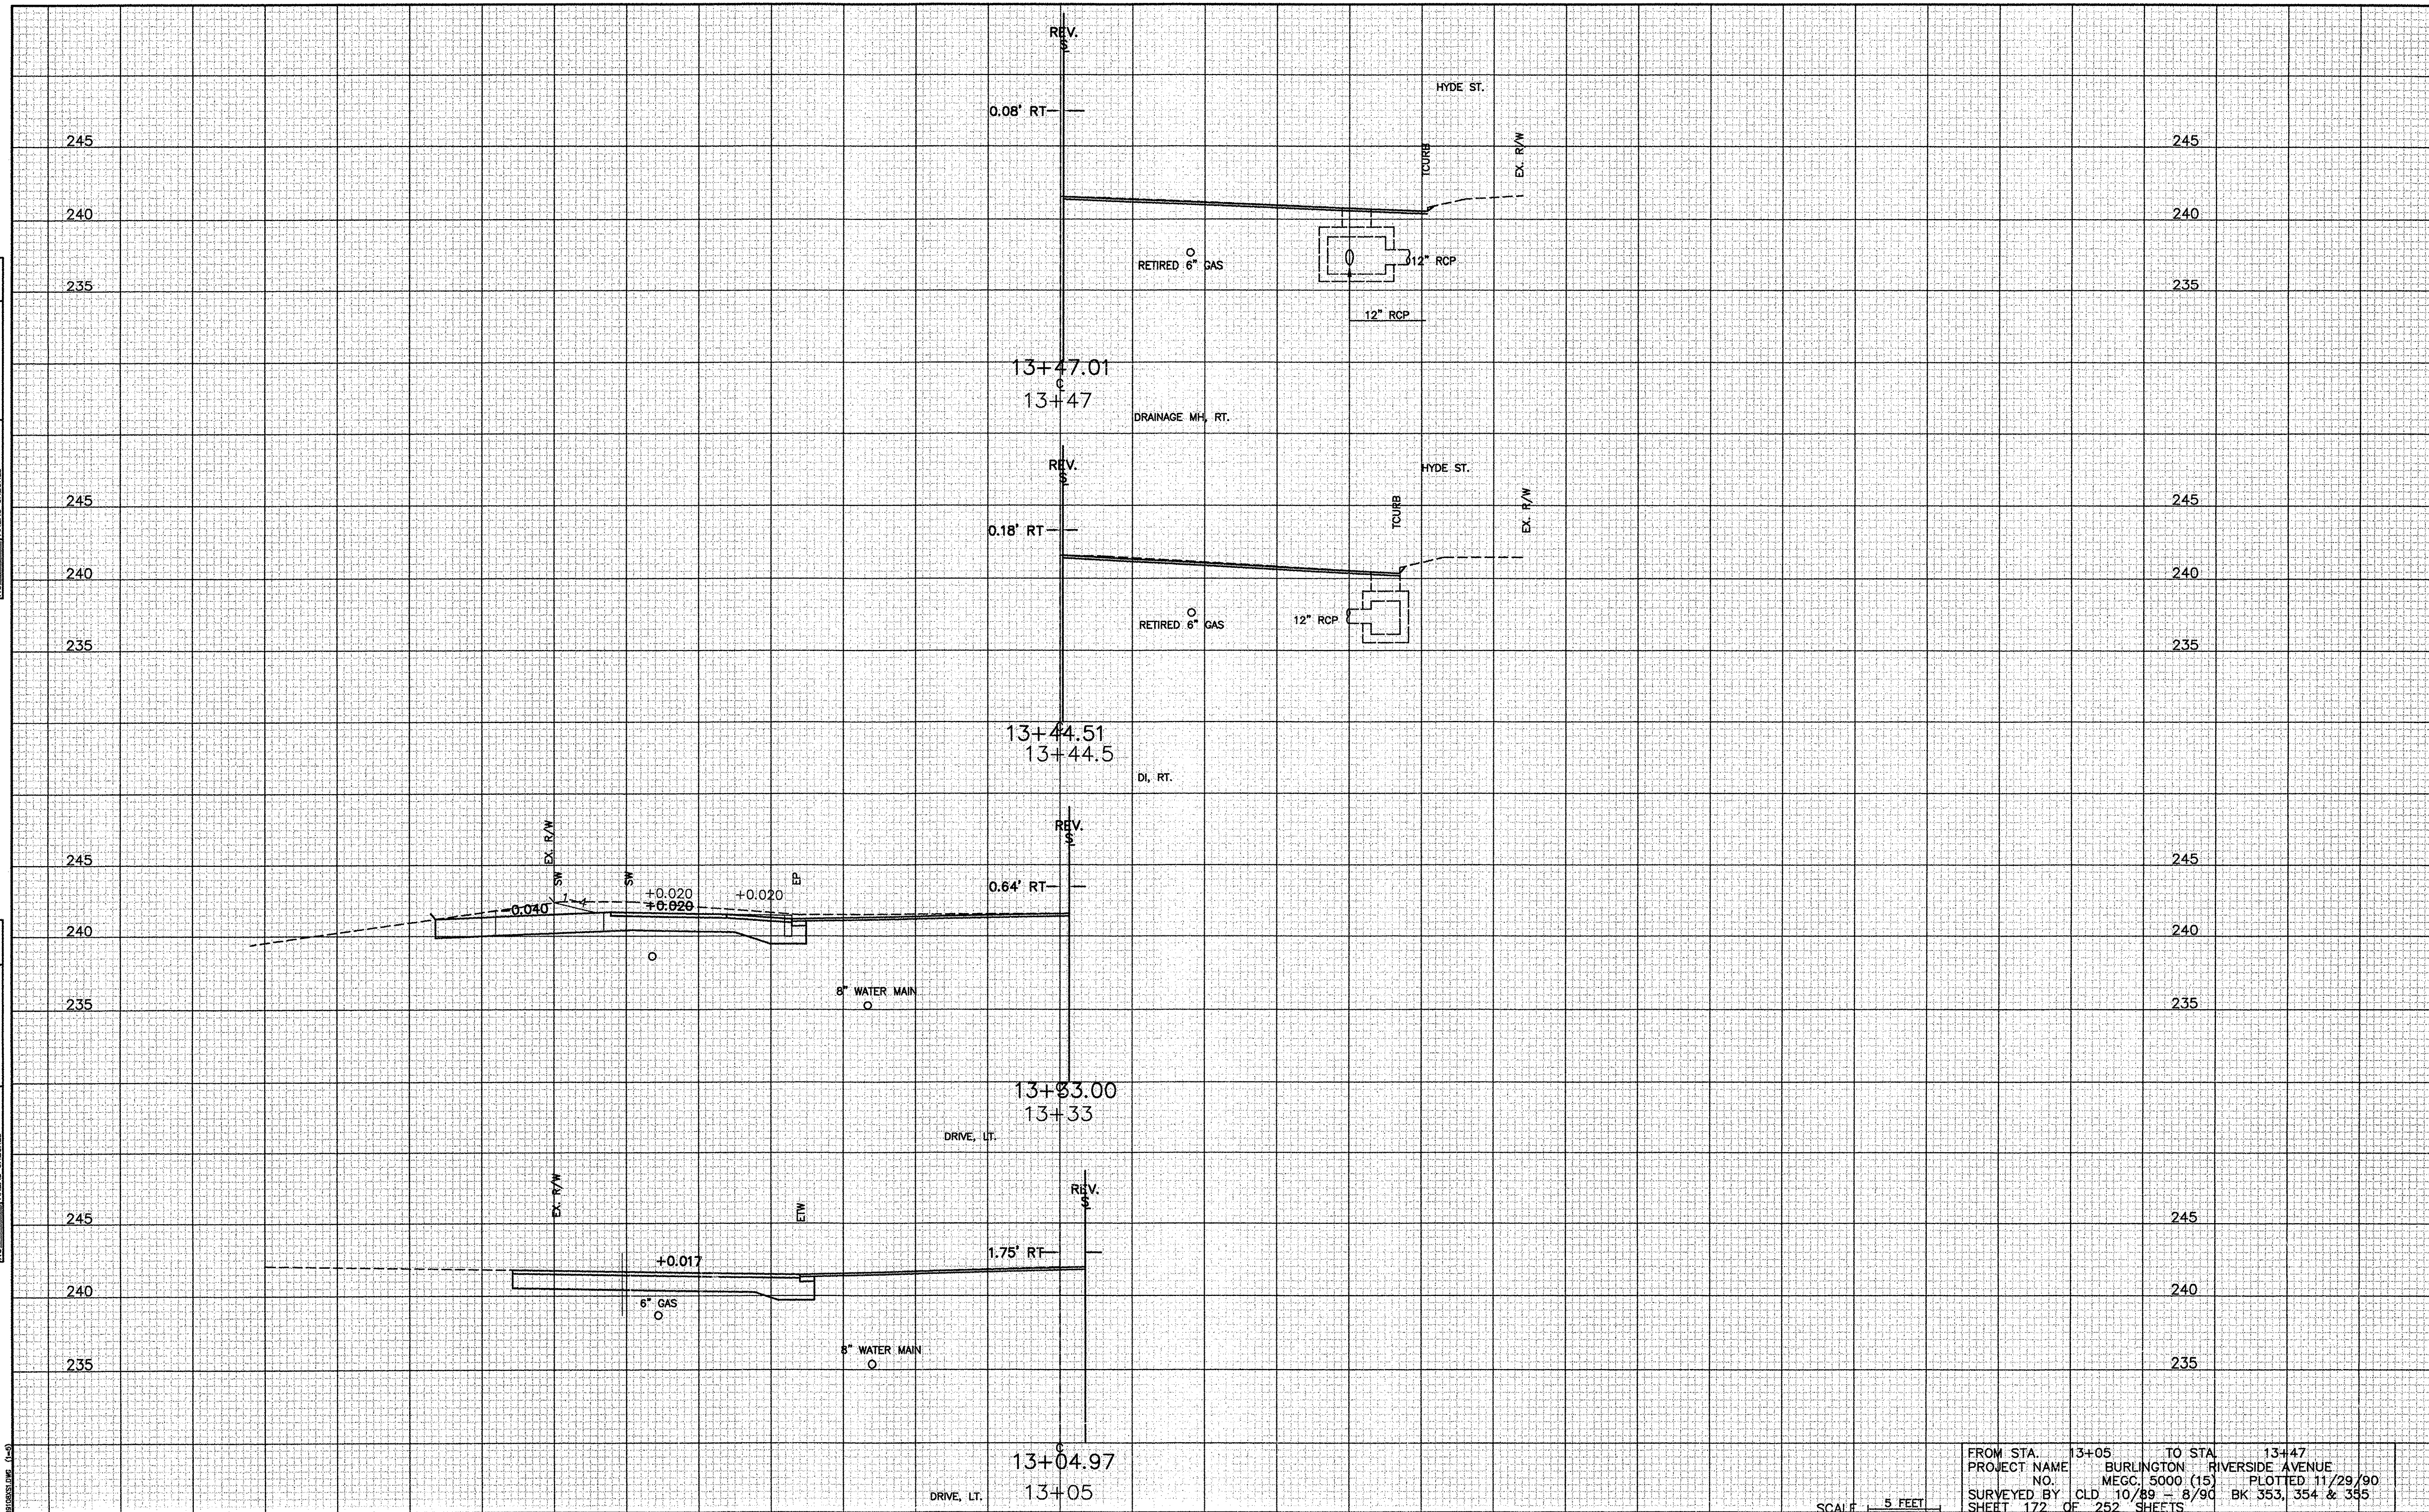

FROM STA. 13+05 TO STA. 13+47
 PROJECT NAME BURLINGTON RIVERSIDE AVENUE
 NO. MEGC. 5000 (15) PLOTTED 11/29/90
 SURVEYED BY CLD 10/89 - 8/90 BK 353, 354 & 355
 SHEET 172 OF 252 SHEETS

SCALE 5 FEET