


DATE	
BY	
FINAL SURVEY	
PLOTTED	
NO. DATE	
AREAS CHECKED	

DATE	
BY	
ORIGINAL SURVEY	
PLOTTED	
NO. DATE	
AREAS CHECKED	

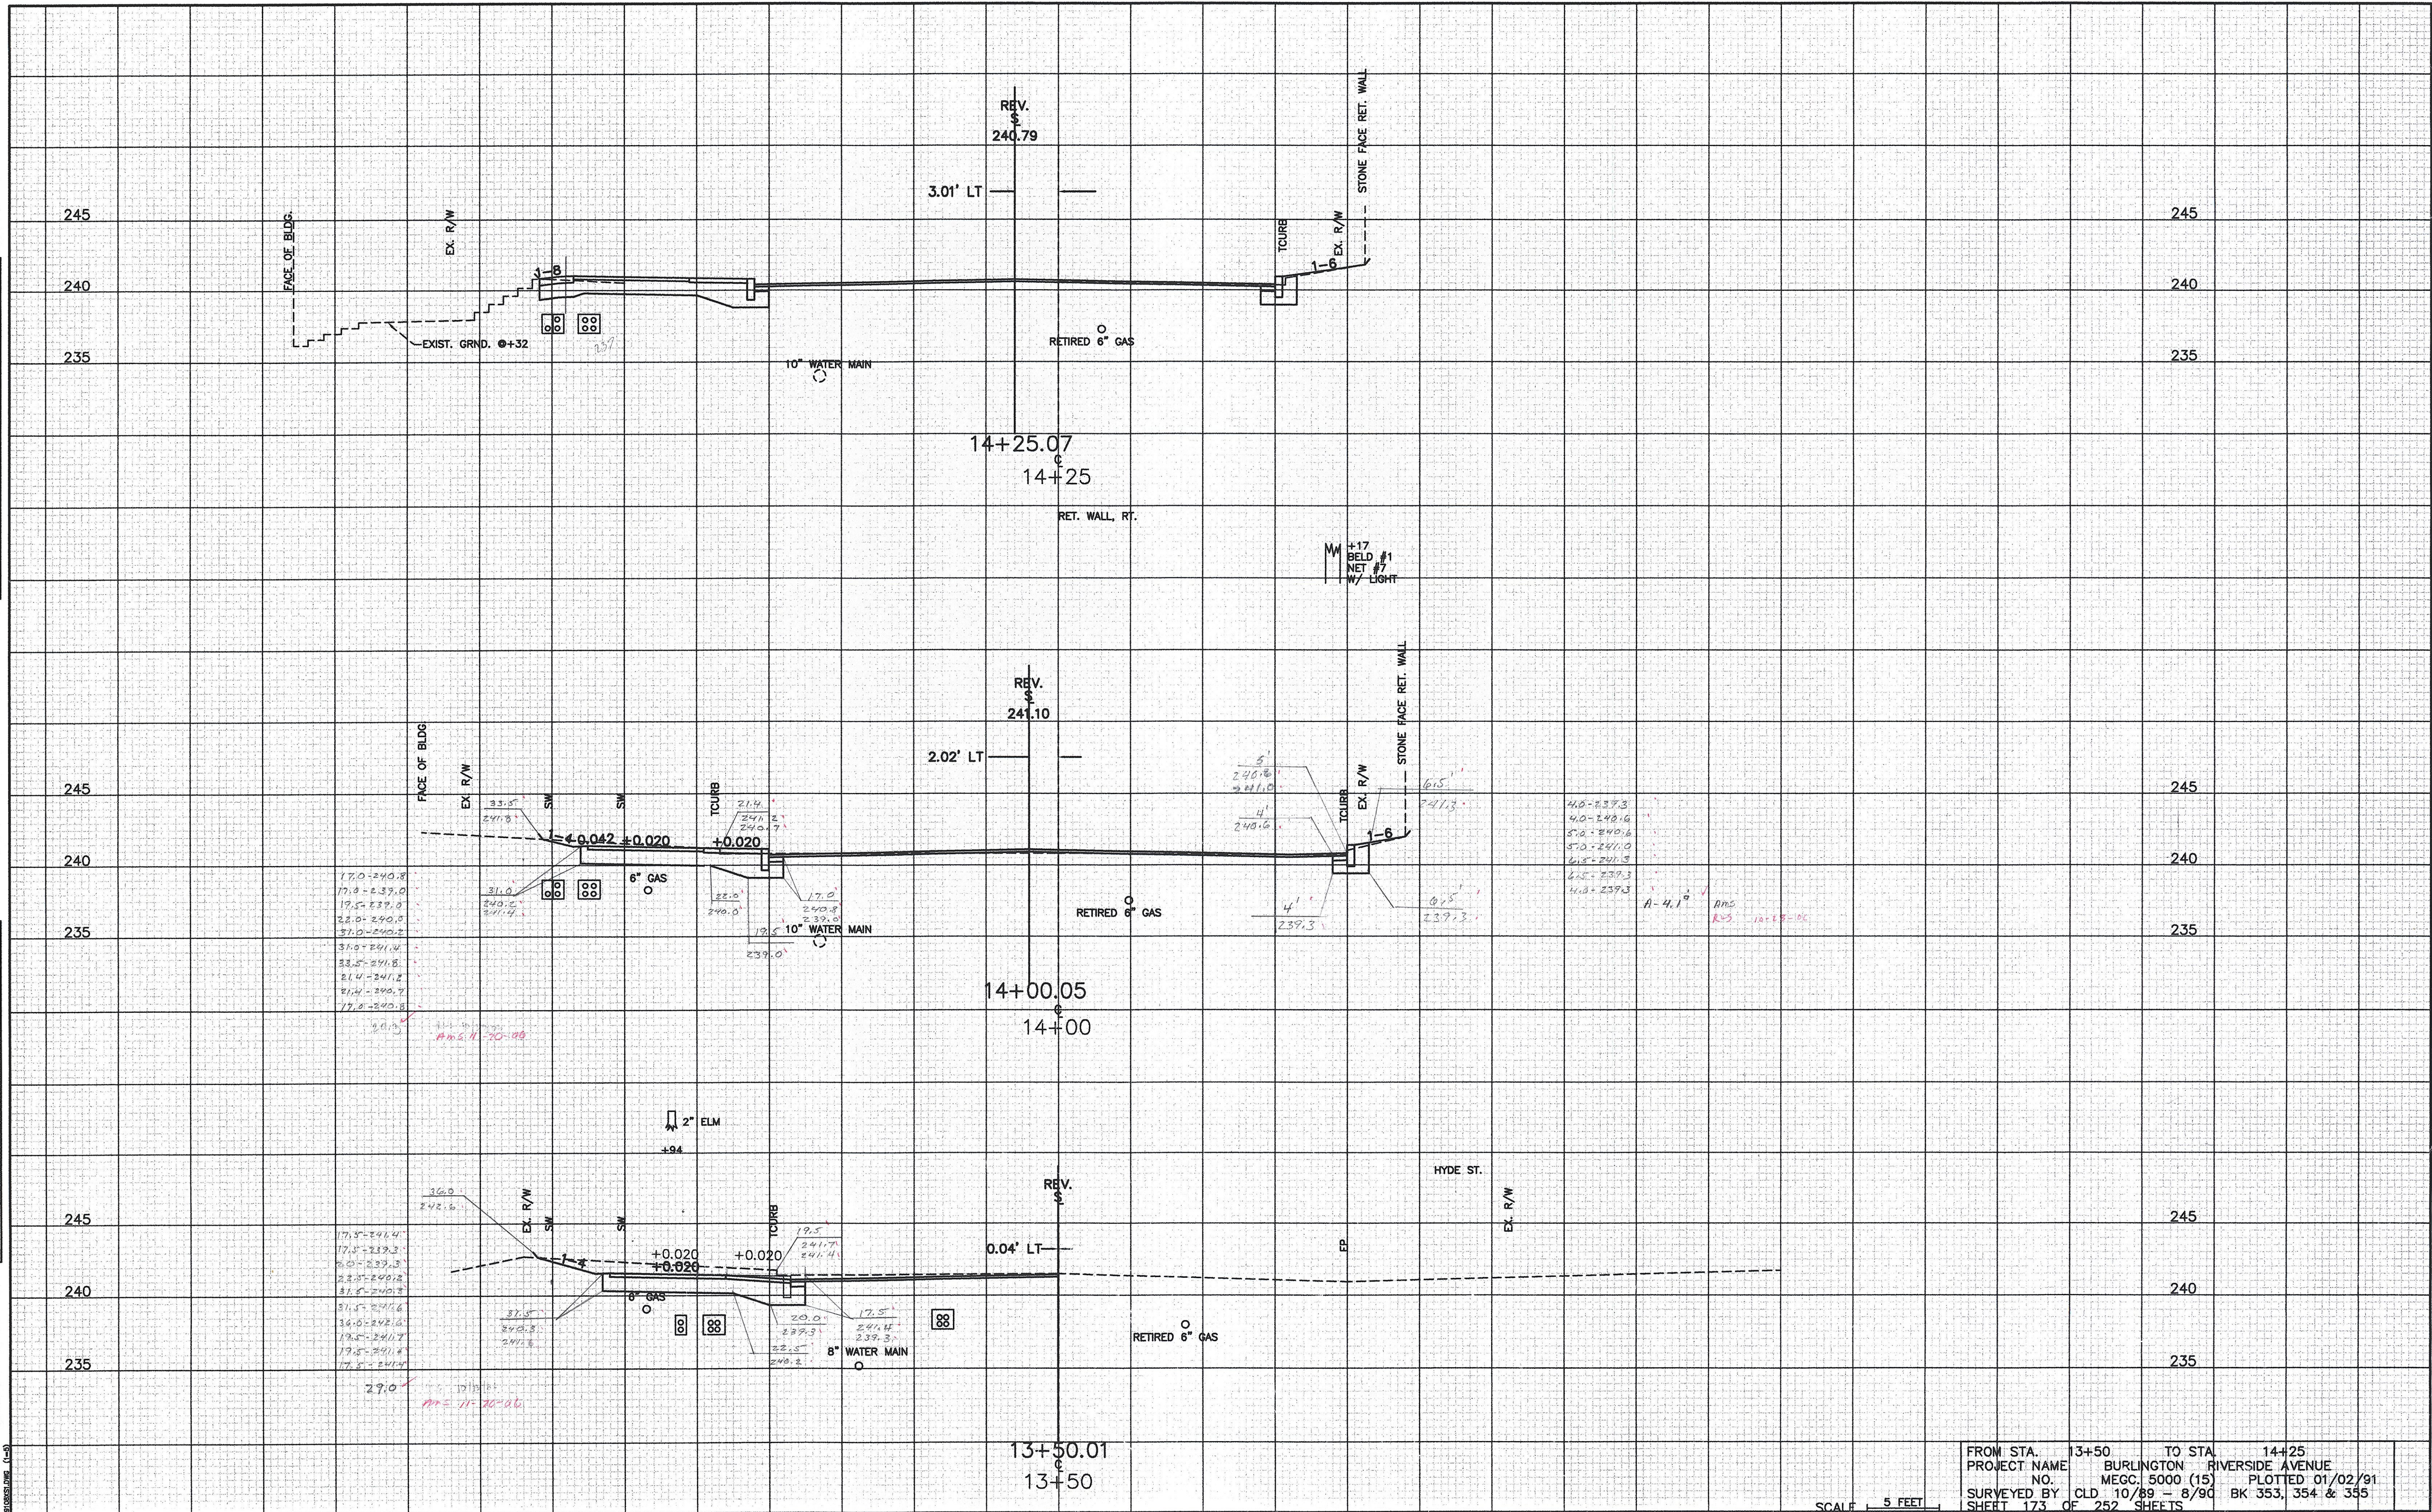

FROM STA. 13+50 TO STA. 14+25
 PROJECT NAME BURLINGTON RIVERSIDE AVENUE
 NO. MECC. 5000 (15) PLOTTED 01/02/91
 SURVEYED BY CLD 10/89 - 8/90 BK 353, 354 & 355
 SHEET 173 OF 252 SHEETS

SCALE 5 FEET

PLOTTED DATE