


FINAL SURVEY NO.	SURVEYED	DATE
NOTEBOOK	PLOTTED	
TEMPLATE	AREAS CHECKED	

ORIGINAL SURVEY NO.	SURVEYED	DATE
NOTEBOOK	PLOTTED	
TEMPLATE	AREAS CHECKED	

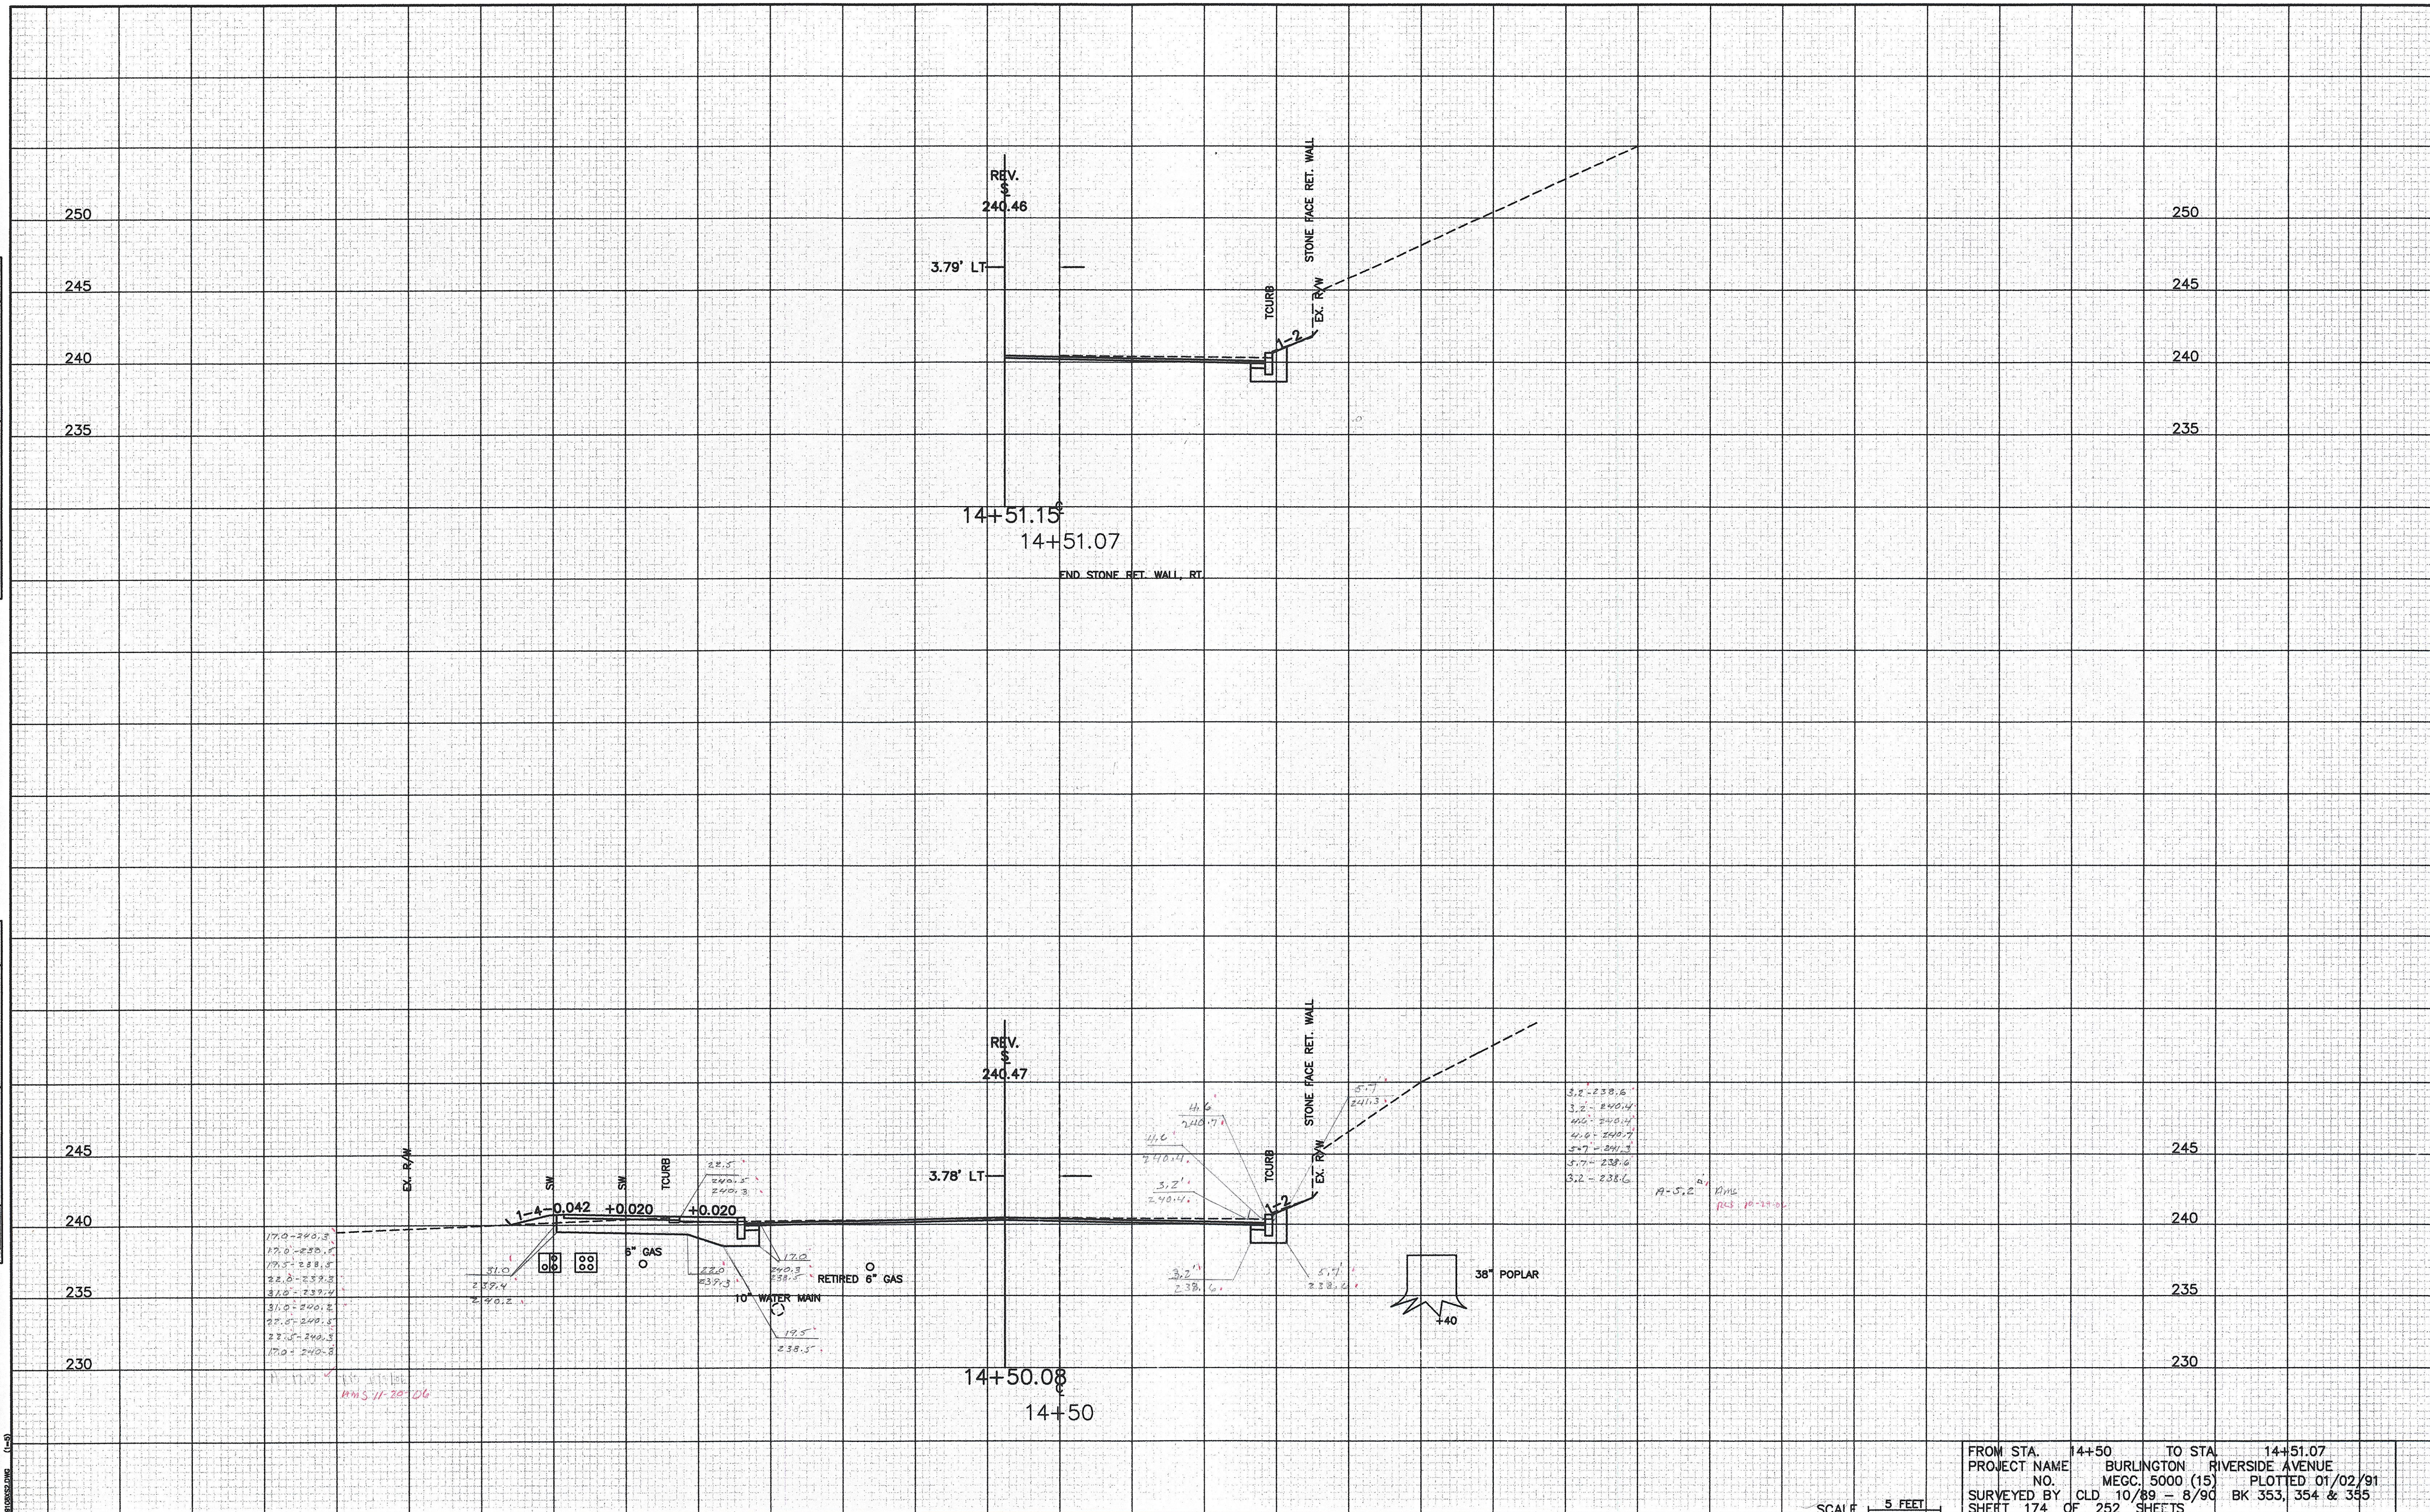

17.0 - 240.3
17.0 - 240.3
3.2 - 238.6
3.2 - 240.14
4.0 - 240.14
4.0 - 240.7
5.7 - 241.3
5.7 - 238.6
3.2 - 238.6

FROM STA. 14+50 TO STA. 14+51.07
 PROJECT NAME BURLINGTON RIVERSIDE AVENUE
 NO. MEGC. 5000 (15) PLOTTED 01/02/91
 SURVEYED BY CLD 10/89 - 8/90 BK 353, 354 & 355
 SHEET 174 OF 252 SHEETS

SCALE 1" = 5 FEET