


DATE	
BY	
FINAL SURVEY	
TEMPLATE	
NOTED	
AREAS CHECKED	
NO.	

DATE	
BY	
ORIGINAL SURVEY	
TEMPLATE	
NOTED	
AREAS CHECKED	
NO.	

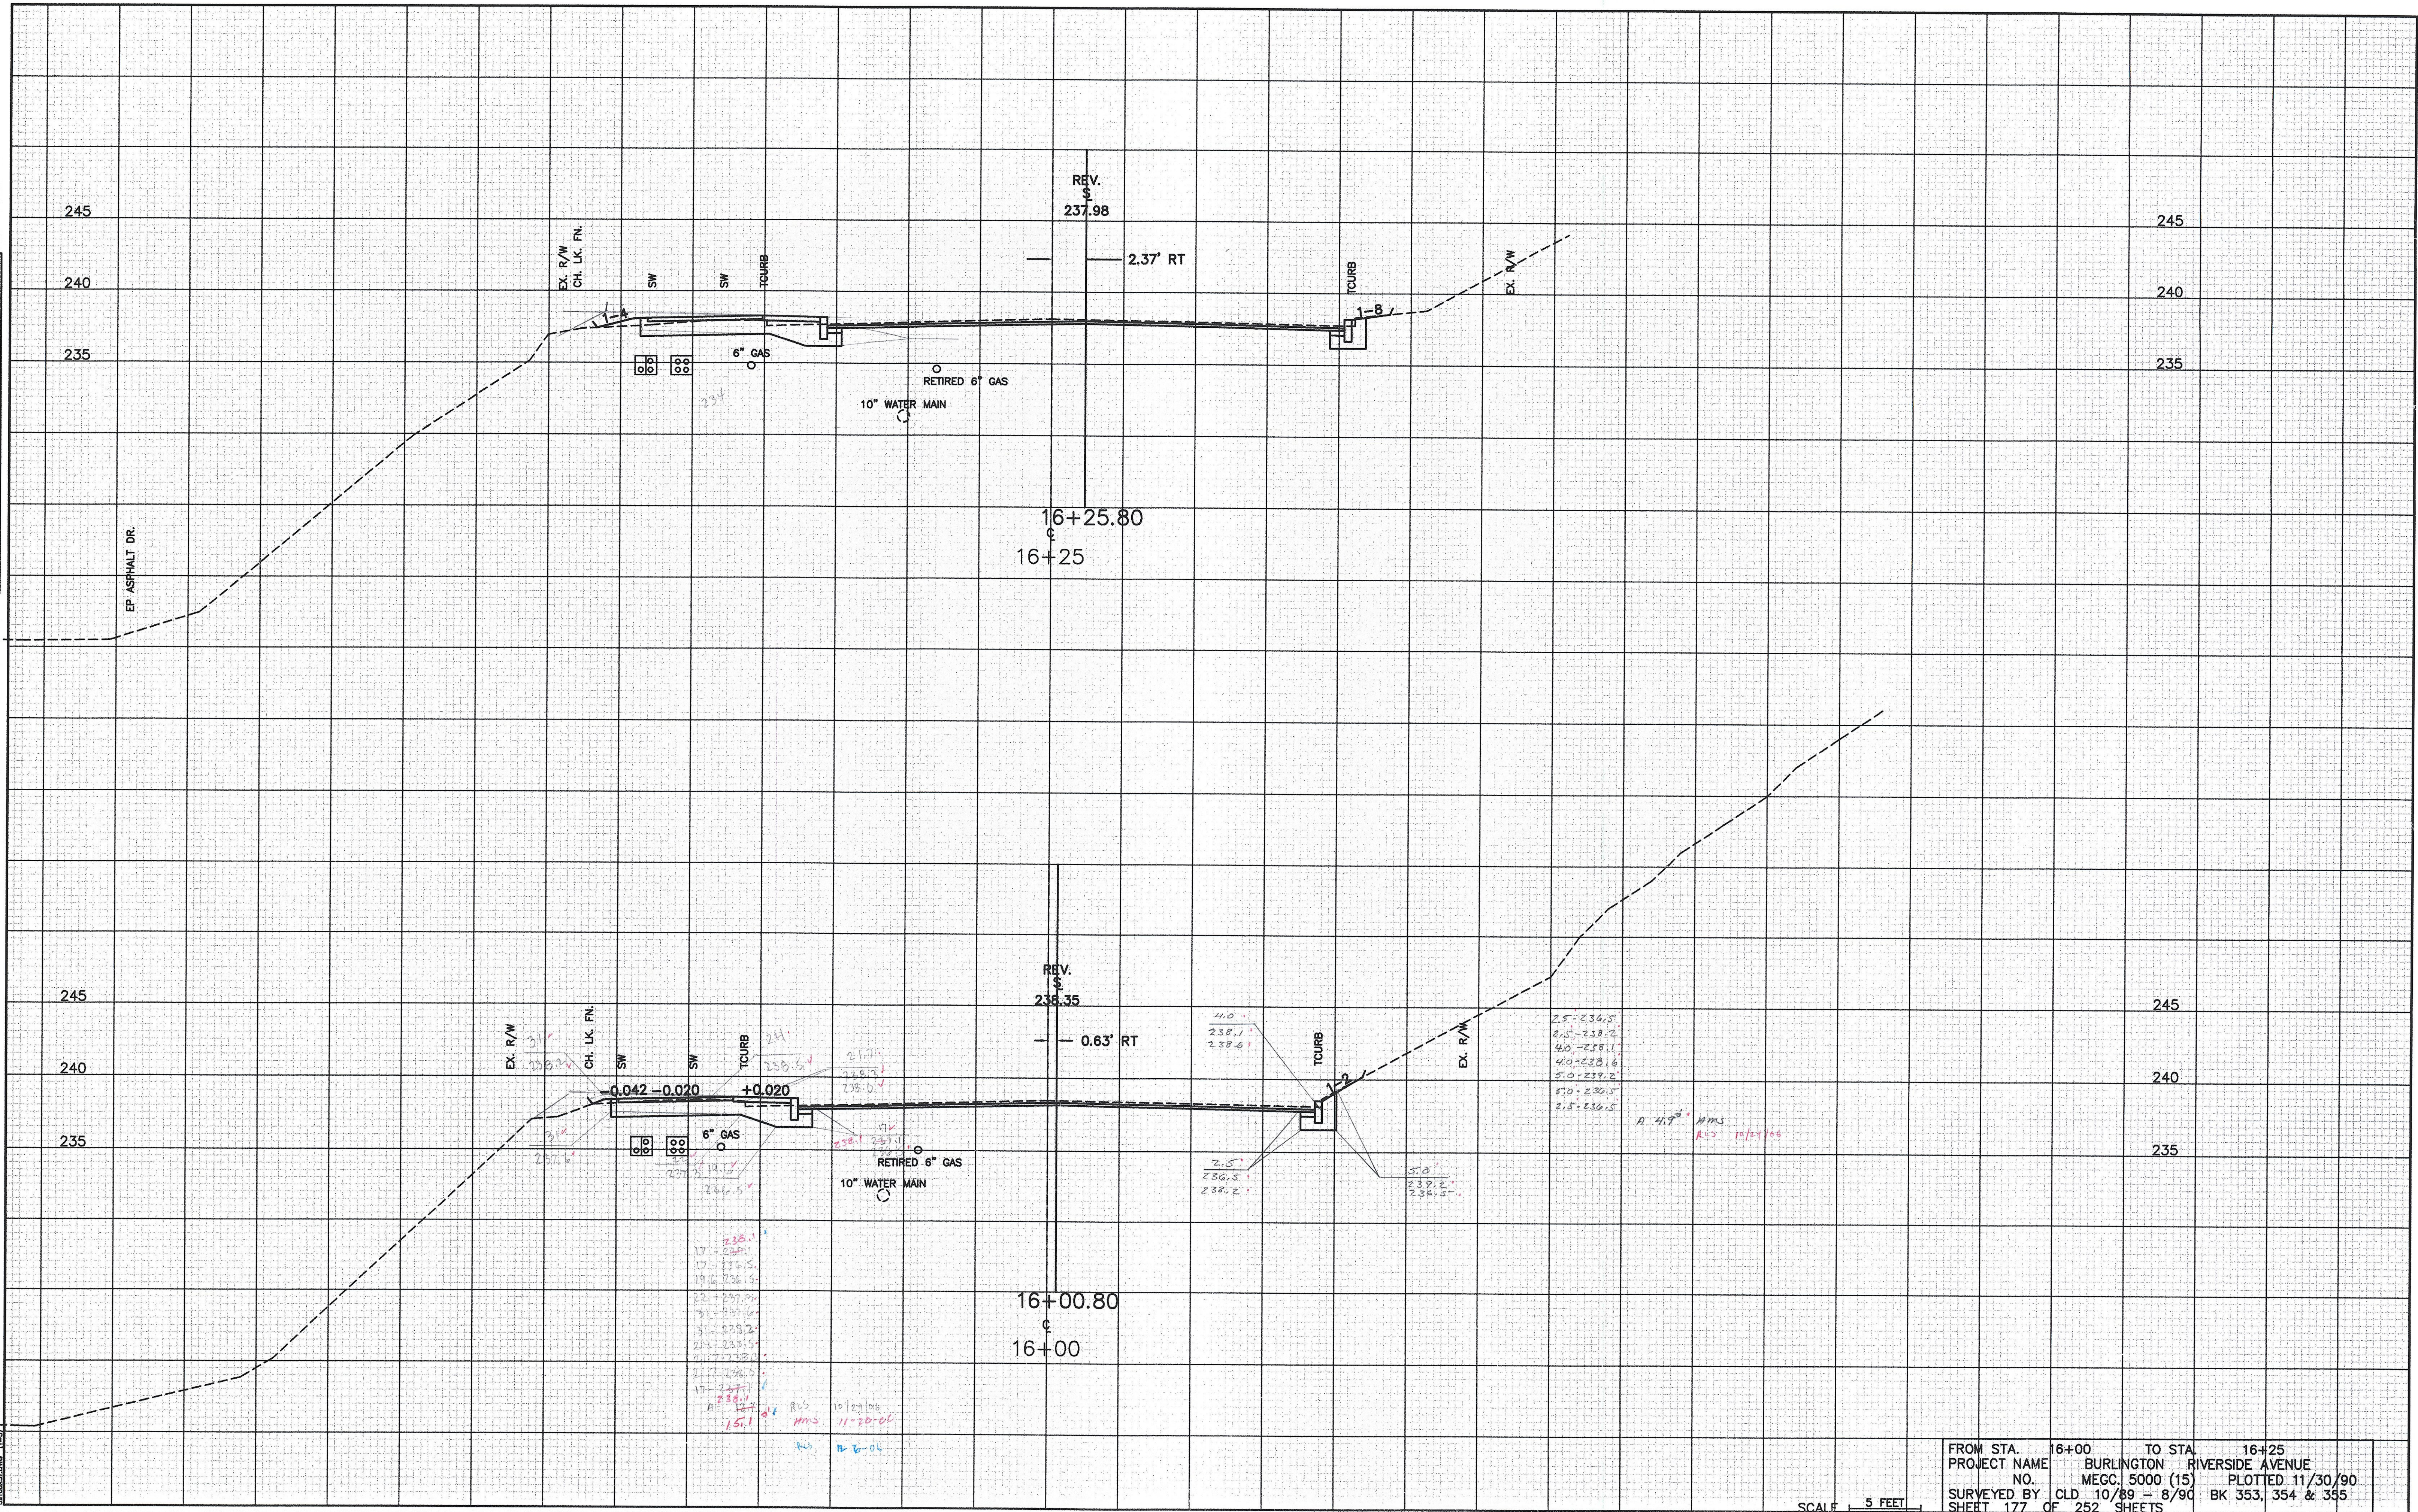

FROM STA. 16+00 TO STA. 16+25  
 PROJECT NAME BURLINGTON RIVERSIDE AVENUE  
 NO. MECC. 5000 (15) PLOTTED 11/30/90  
 SURVEYED BY CLD 10/89 - 8/90 BK 353, 354 & 355  
 SHEET 177 OF 252 SHEETS

SCALE 5 FEET

10/30/90