
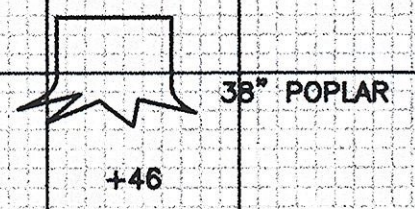


DATE	
BY	
NO.	
AREAS CHECKED	
AREAS	
TEMPLATE	
FINAL SURVEY	
NOTEBOOK	

DATE	
BY	
NO.	
AREAS CHECKED	
AREAS	
TEMPLATE	
ORIGINAL SURVEY	
NOTEBOOK	

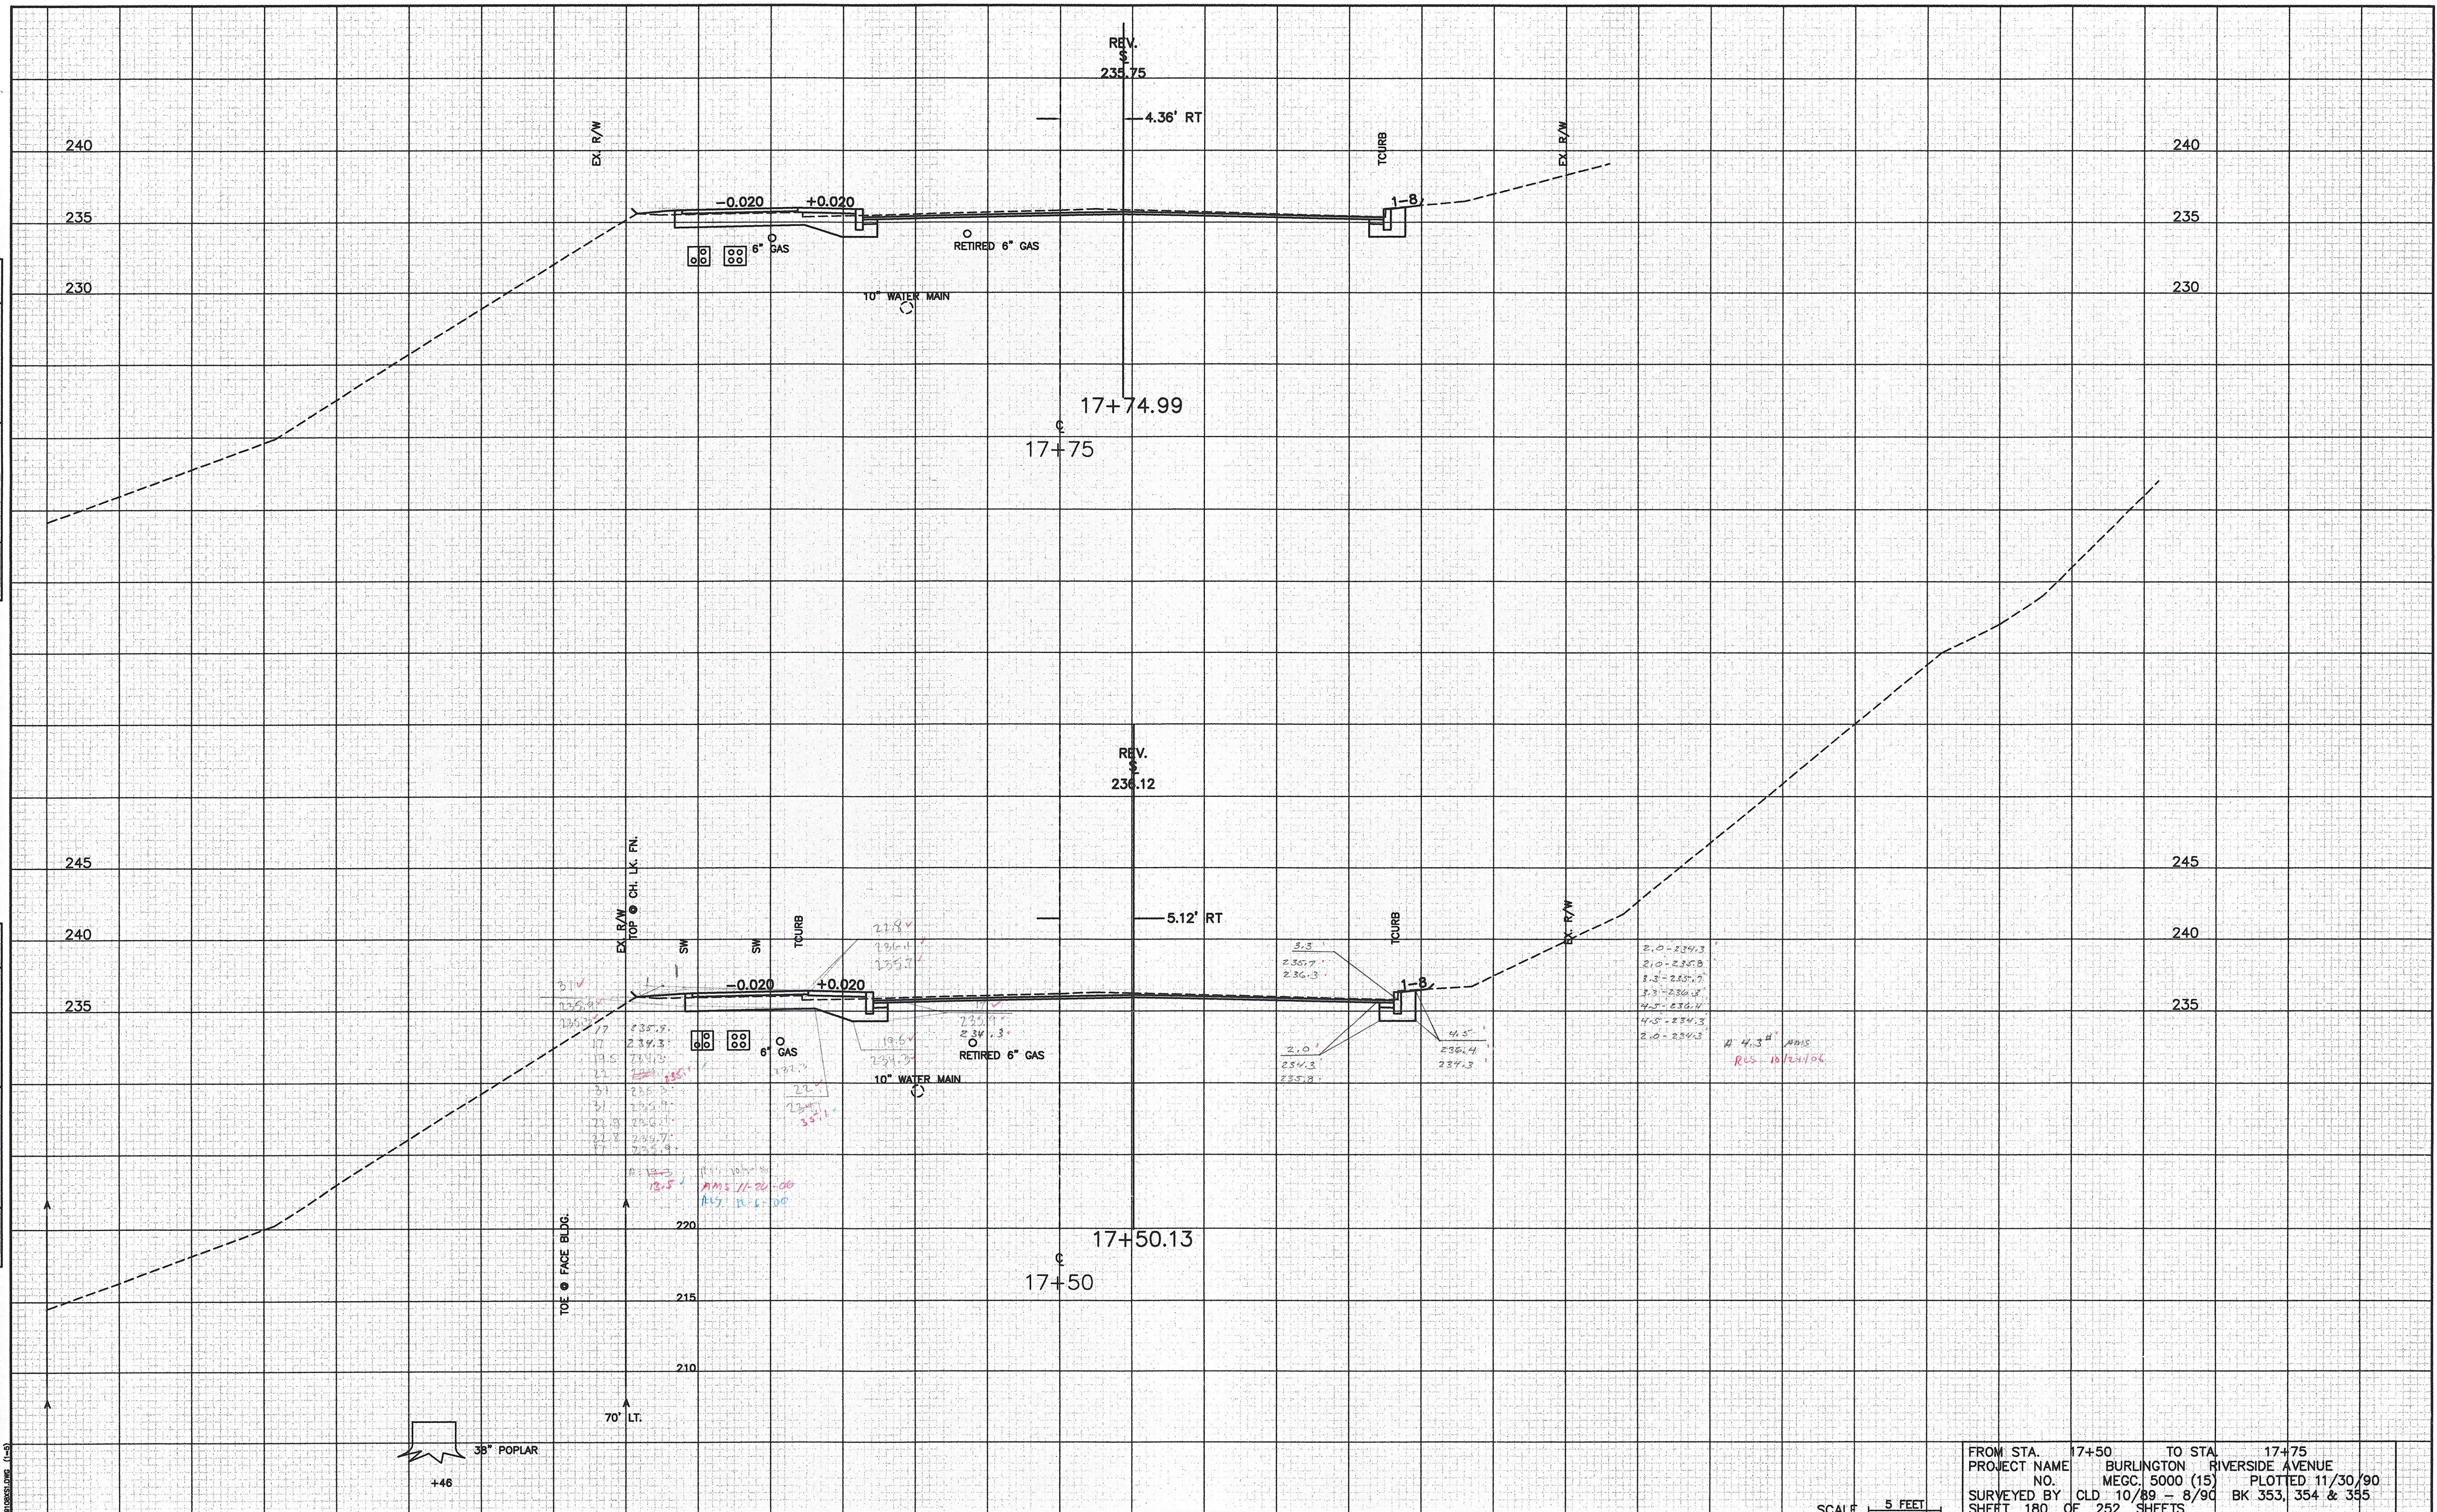

FROM STA. 17+50 TO STA. 17+75
 PROJECT NAME BURLINGTON RIVERSIDE AVENUE
 NO. MECC, 5000 (15) PLOTTED 11/30/90
 SURVEYED BY CLD 10/89 - 8/90 BK 353, 354 & 355
 SHEET 180 OF 252 SHEETS

SCALE 5 FEET