


DATE	
BY	
FINAL SURVEY NOTEBOOK NO.	
SURVEYED	
PLOTTED	
AREA	
AREAS CHECKED	

DATE	
BY	
ORIGINAL SURVEY NOTEBOOK NO.	
SURVEYED	
PLOTTED	
AREA	
AREAS CHECKED	

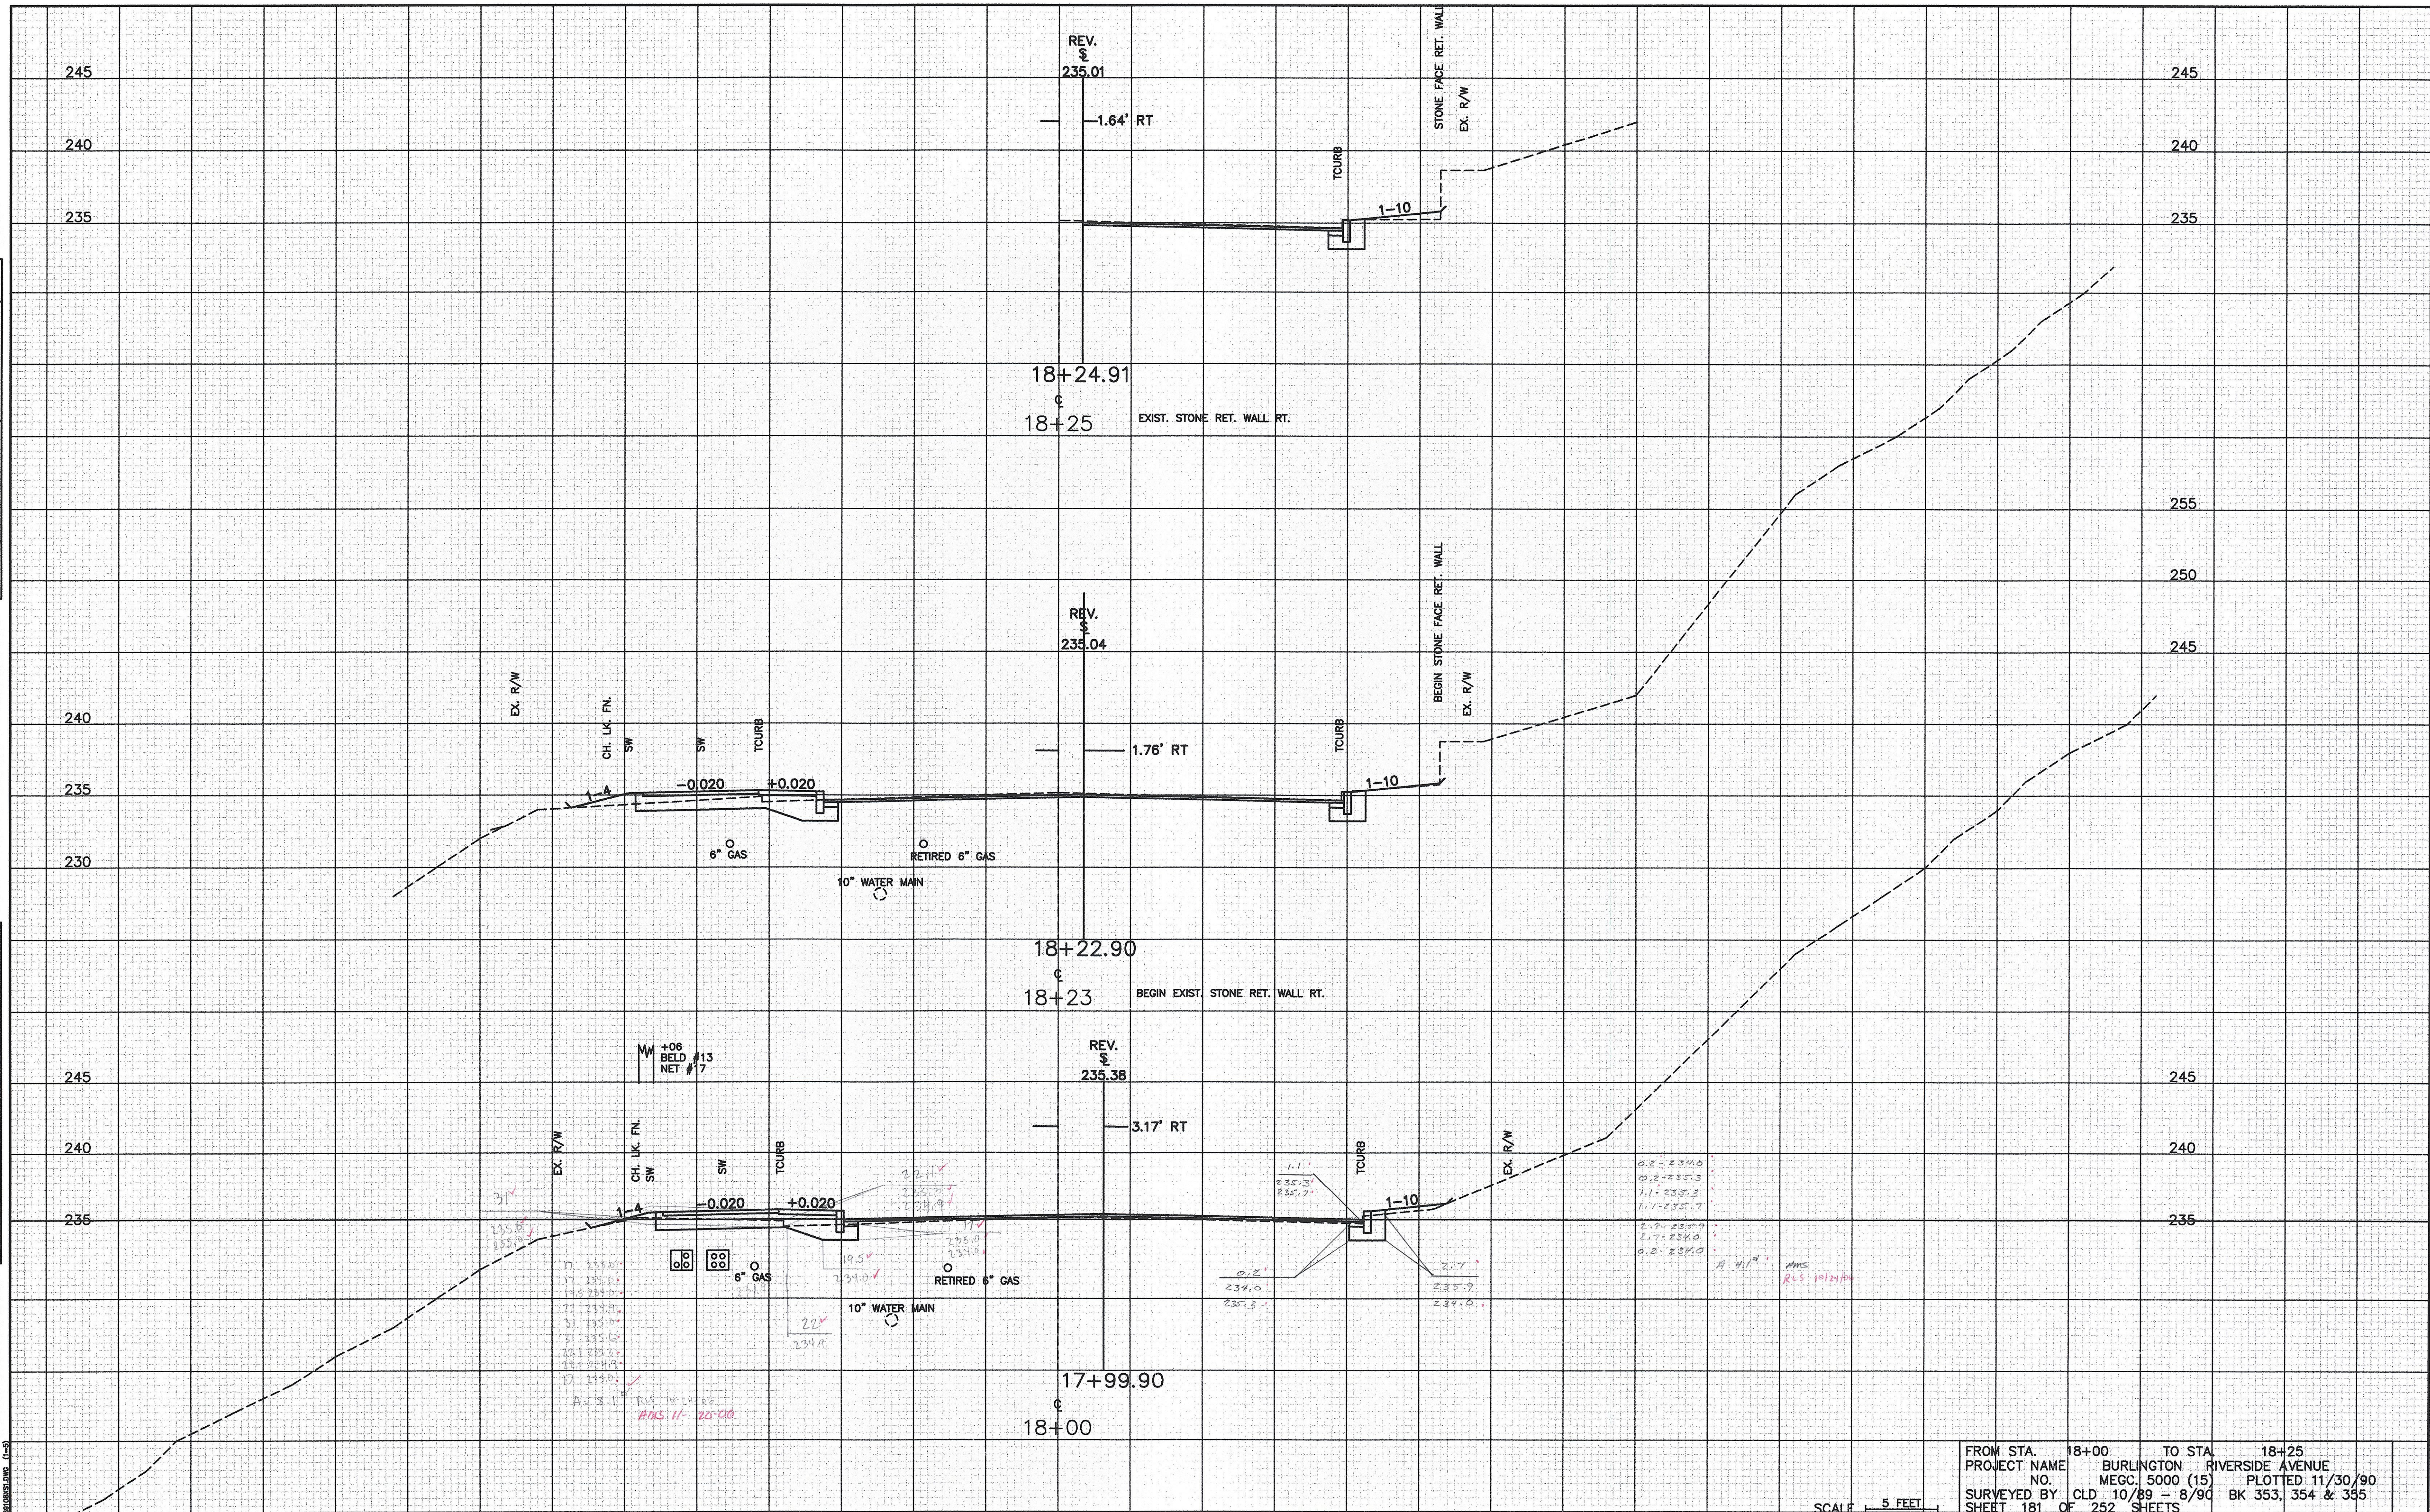

FROM STA. 18+00 TO STA. 18+25  
 PROJECT NAME BURLINGTON RIVERSIDE AVENUE  
 NO. MECC. 5000 (15) PLOTTED 11/30/90  
 SURVEYED BY CLD 10/89 - 8/90 BK 353, 354 & 355  
 SHEET 181 OF 252 SHEETS

SCALE 5 FEET

PL 08/85 (1-3)