


DATE	
BY	
SURVEYED	
PLOTTED	
NOTED	
AREAS	
NO.	
CHECKED	

DATE	
BY	
SURVEYED	
PLOTTED	
NOTED	
AREAS	
NO.	
CHECKED	

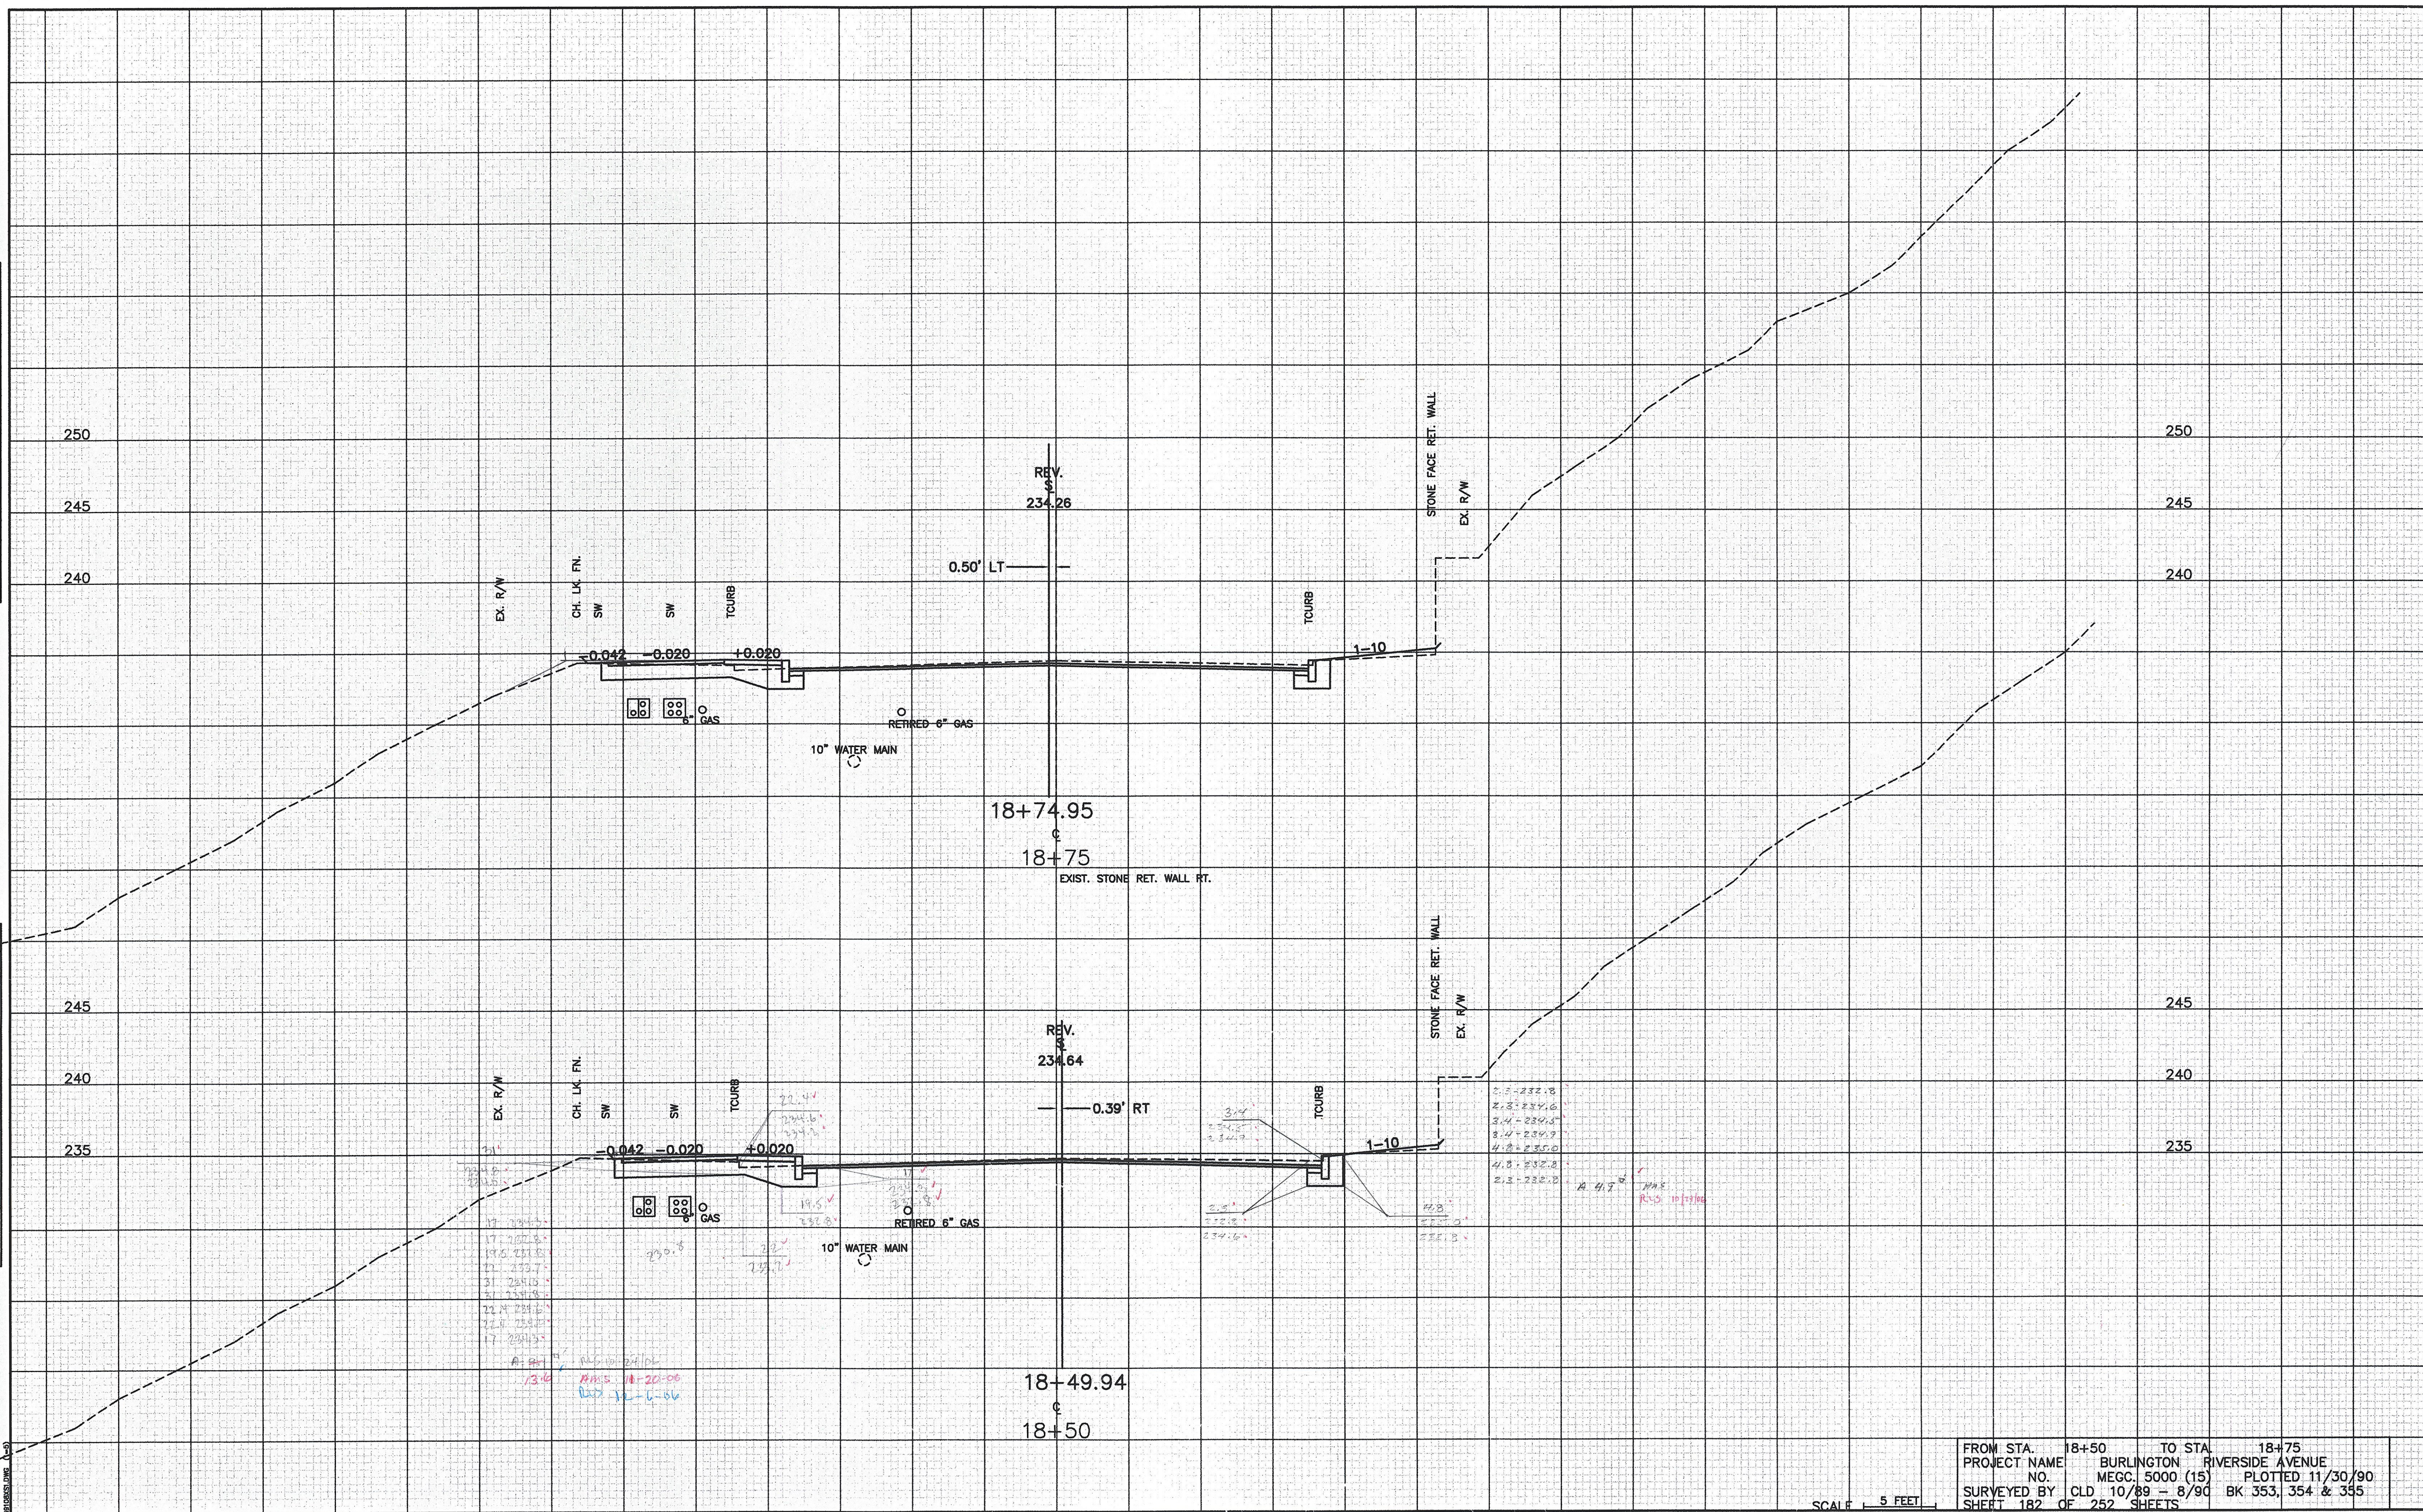

17 234.5
 17 232.5
 19.5 231.2
 21 232.7
 31 234.5
 41 231.8
 22.4 234.5
 22.8 234.5
 17 234.5
 A-417
 13.6
 11/20/00
 11/20/00

21.5 - 232.8
 21.8 - 234.6
 31.4 - 234.4
 31.4 - 234.7
 41.2 - 235.0
 41.8 - 232.8
 21.2 - 232.8
 A-417
 11/20/00

FROM STA. 18+50 TO STA. 18+75
 PROJECT NAME BURLINGTON RIVERSIDE AVENUE
 NO. MECC. 5000 (15) PLOTTED 11/30/90
 SURVEYED BY CLD 10/89 - 8/90 BK 353, 354 & 355
 SHEET 182 OF 252 SHEETS

SCALE 5 FEET