


DATE	
BY	
FINAL SURVEY	
FLIGHT	
NOTED	
NO	
AREAS CHECKED	

DATE	
BY	
ORIGINAL SURVEY	
TEMPLATE	
NOTED	
NO	
AREAS CHECKED	

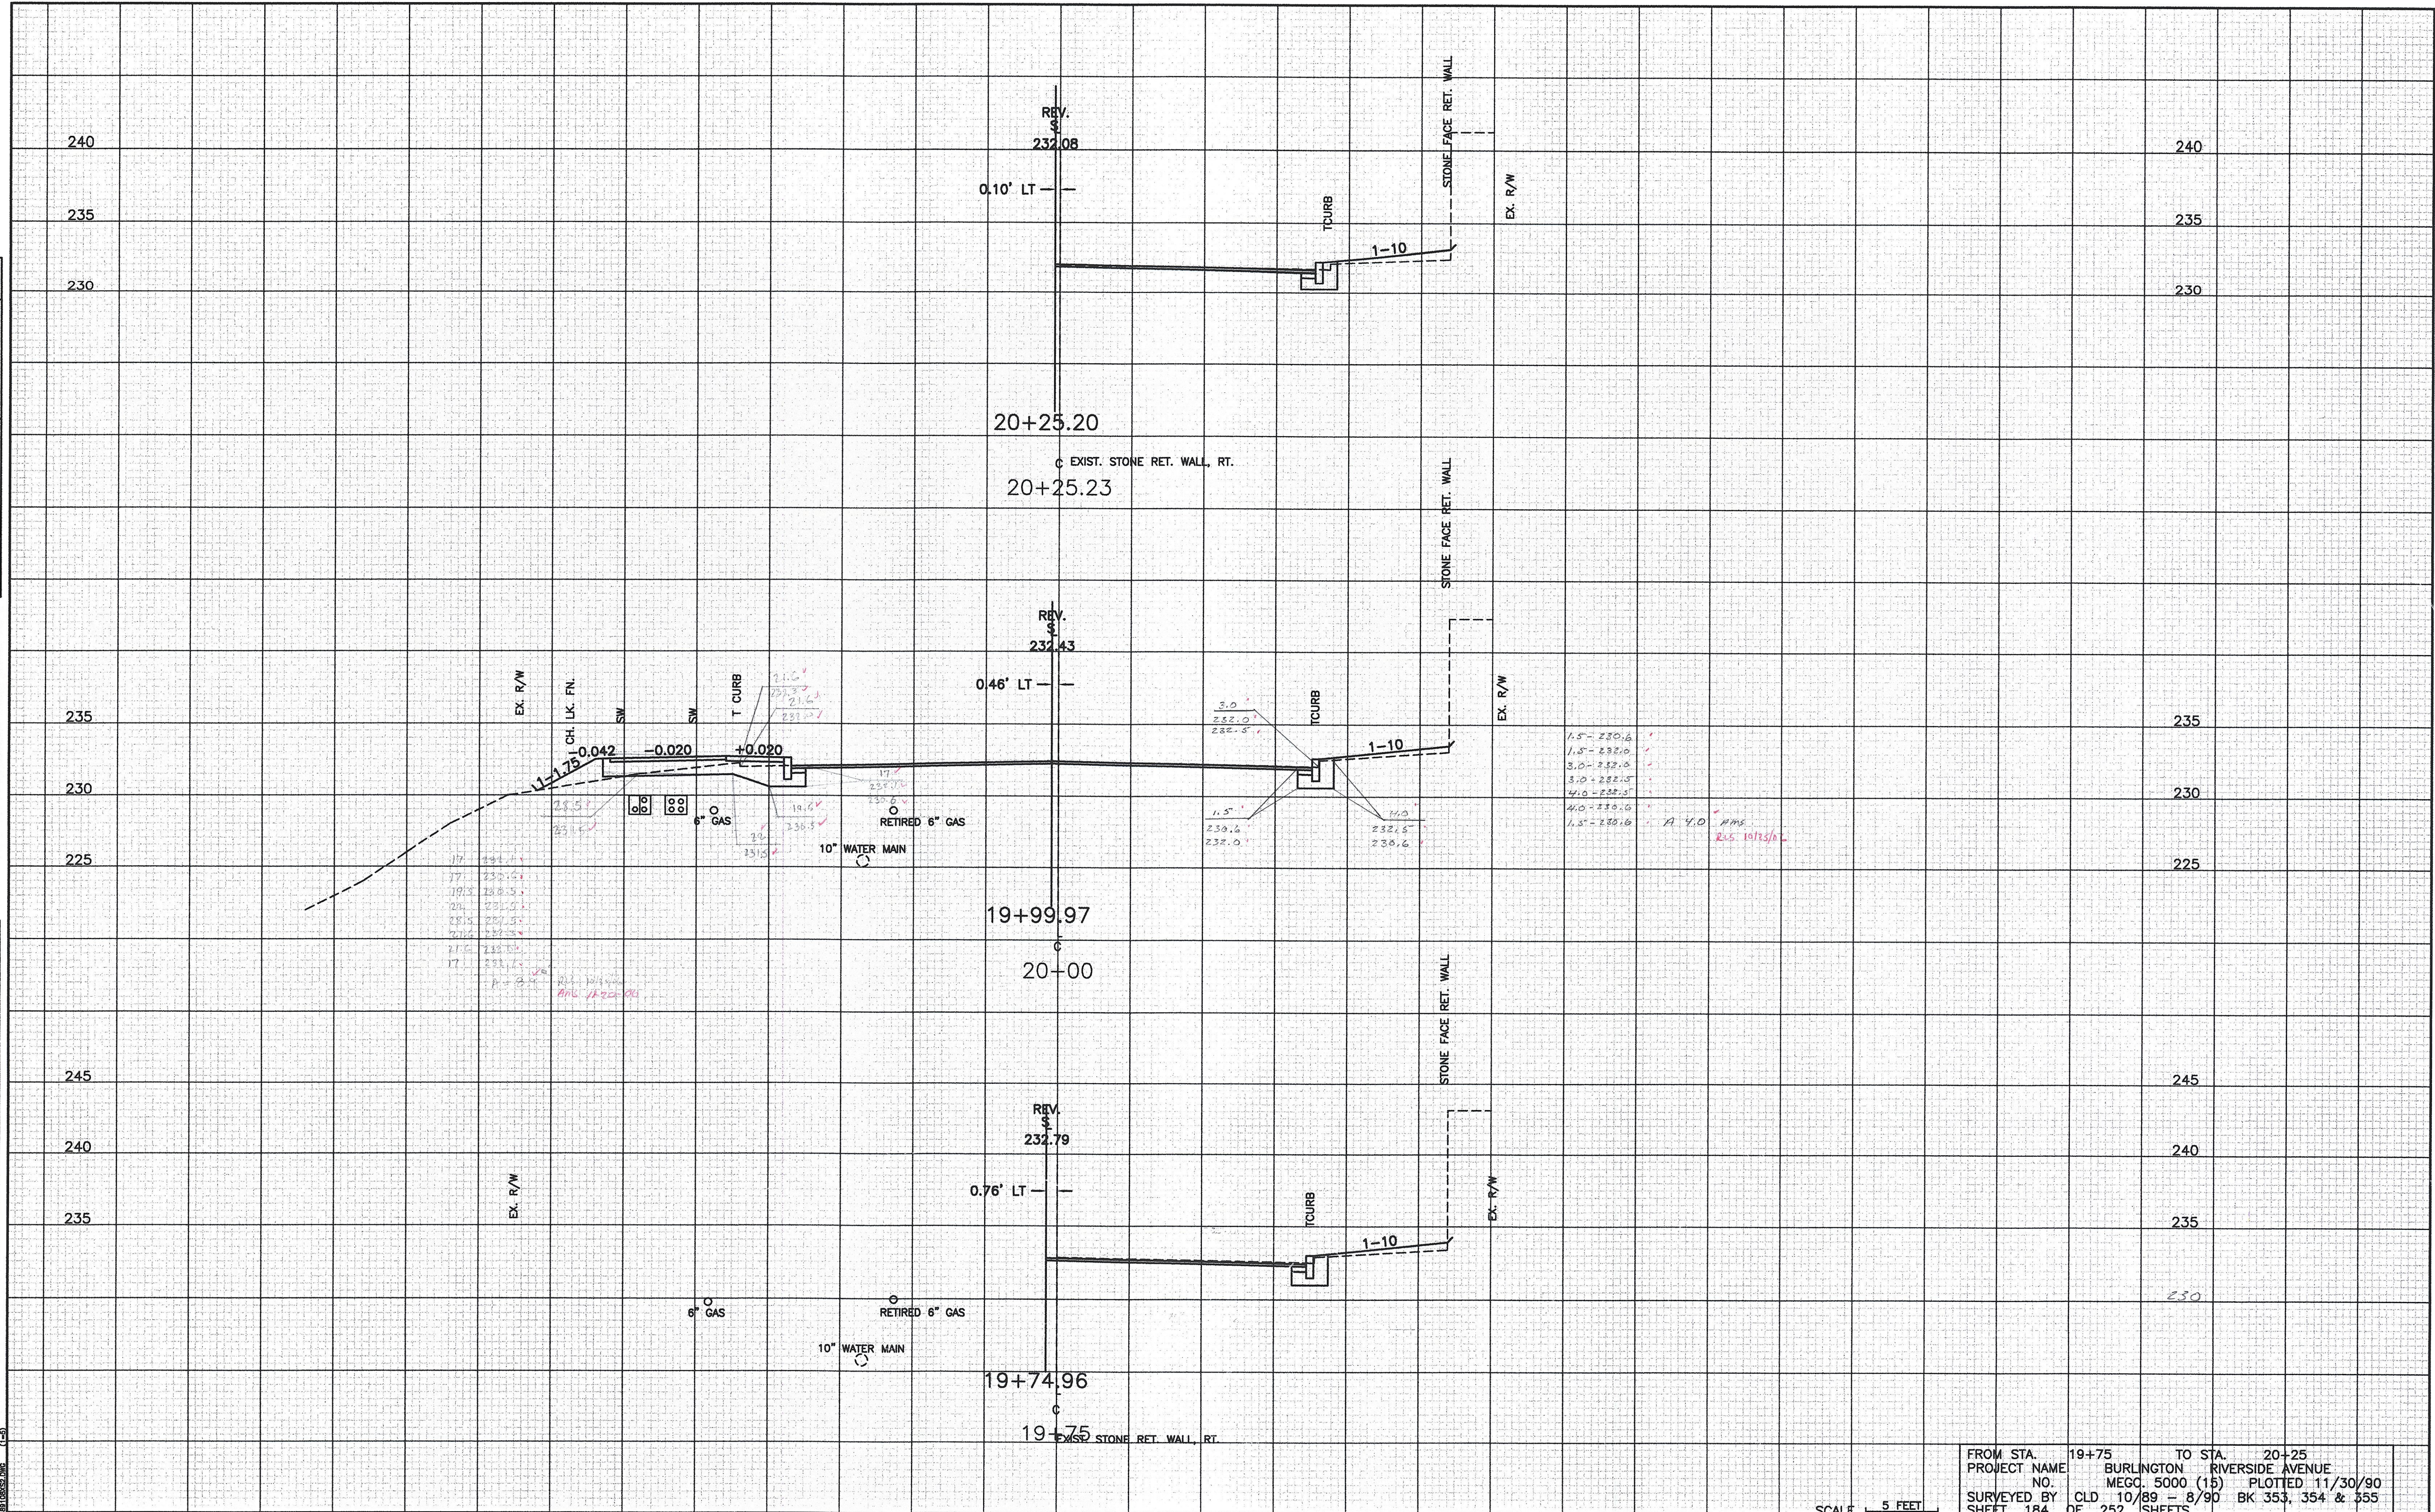

FROM STA. 19+75 TO STA. 20+25
 PROJECT NAME BURLINGTON RIVERSIDE AVENUE
 NO. MEGC. 5000 (15) PLOTTED 11/30/90
 SURVEYED BY CLD 10/89 - 8/90 BK 353, 354 & 355
 SHEET 184 OF 252 SHEETS

SCALE 5 FEET