

224 25'
200 125'
226.6
225.5
1.1
100 24


③ REV. STA 24+02 LT
NEW 15" X 4' CSP
NEW 15" X 4' RCP CLASS III
NEW 6" X 6" RCCB W/C.I. GRATE TYPE D

125' LT.
128' LT.
TOP 15" CMP
● 24+23; ELEV. = 200.0

OUTLET 15" CMP
● 24+13; ELEV. = 194.3

DATE	
BY	
FINAL SURVEY	
NO. OF SHEETS	
NO. OF SHEETS CHECKED	
NO. OF SHEETS	
NO. OF SHEETS	

DATE	
BY	
ORIGINAL SURVEY	
NO. OF SHEETS	
NO. OF SHEETS CHECKED	
NO. OF SHEETS	
NO. OF SHEETS	

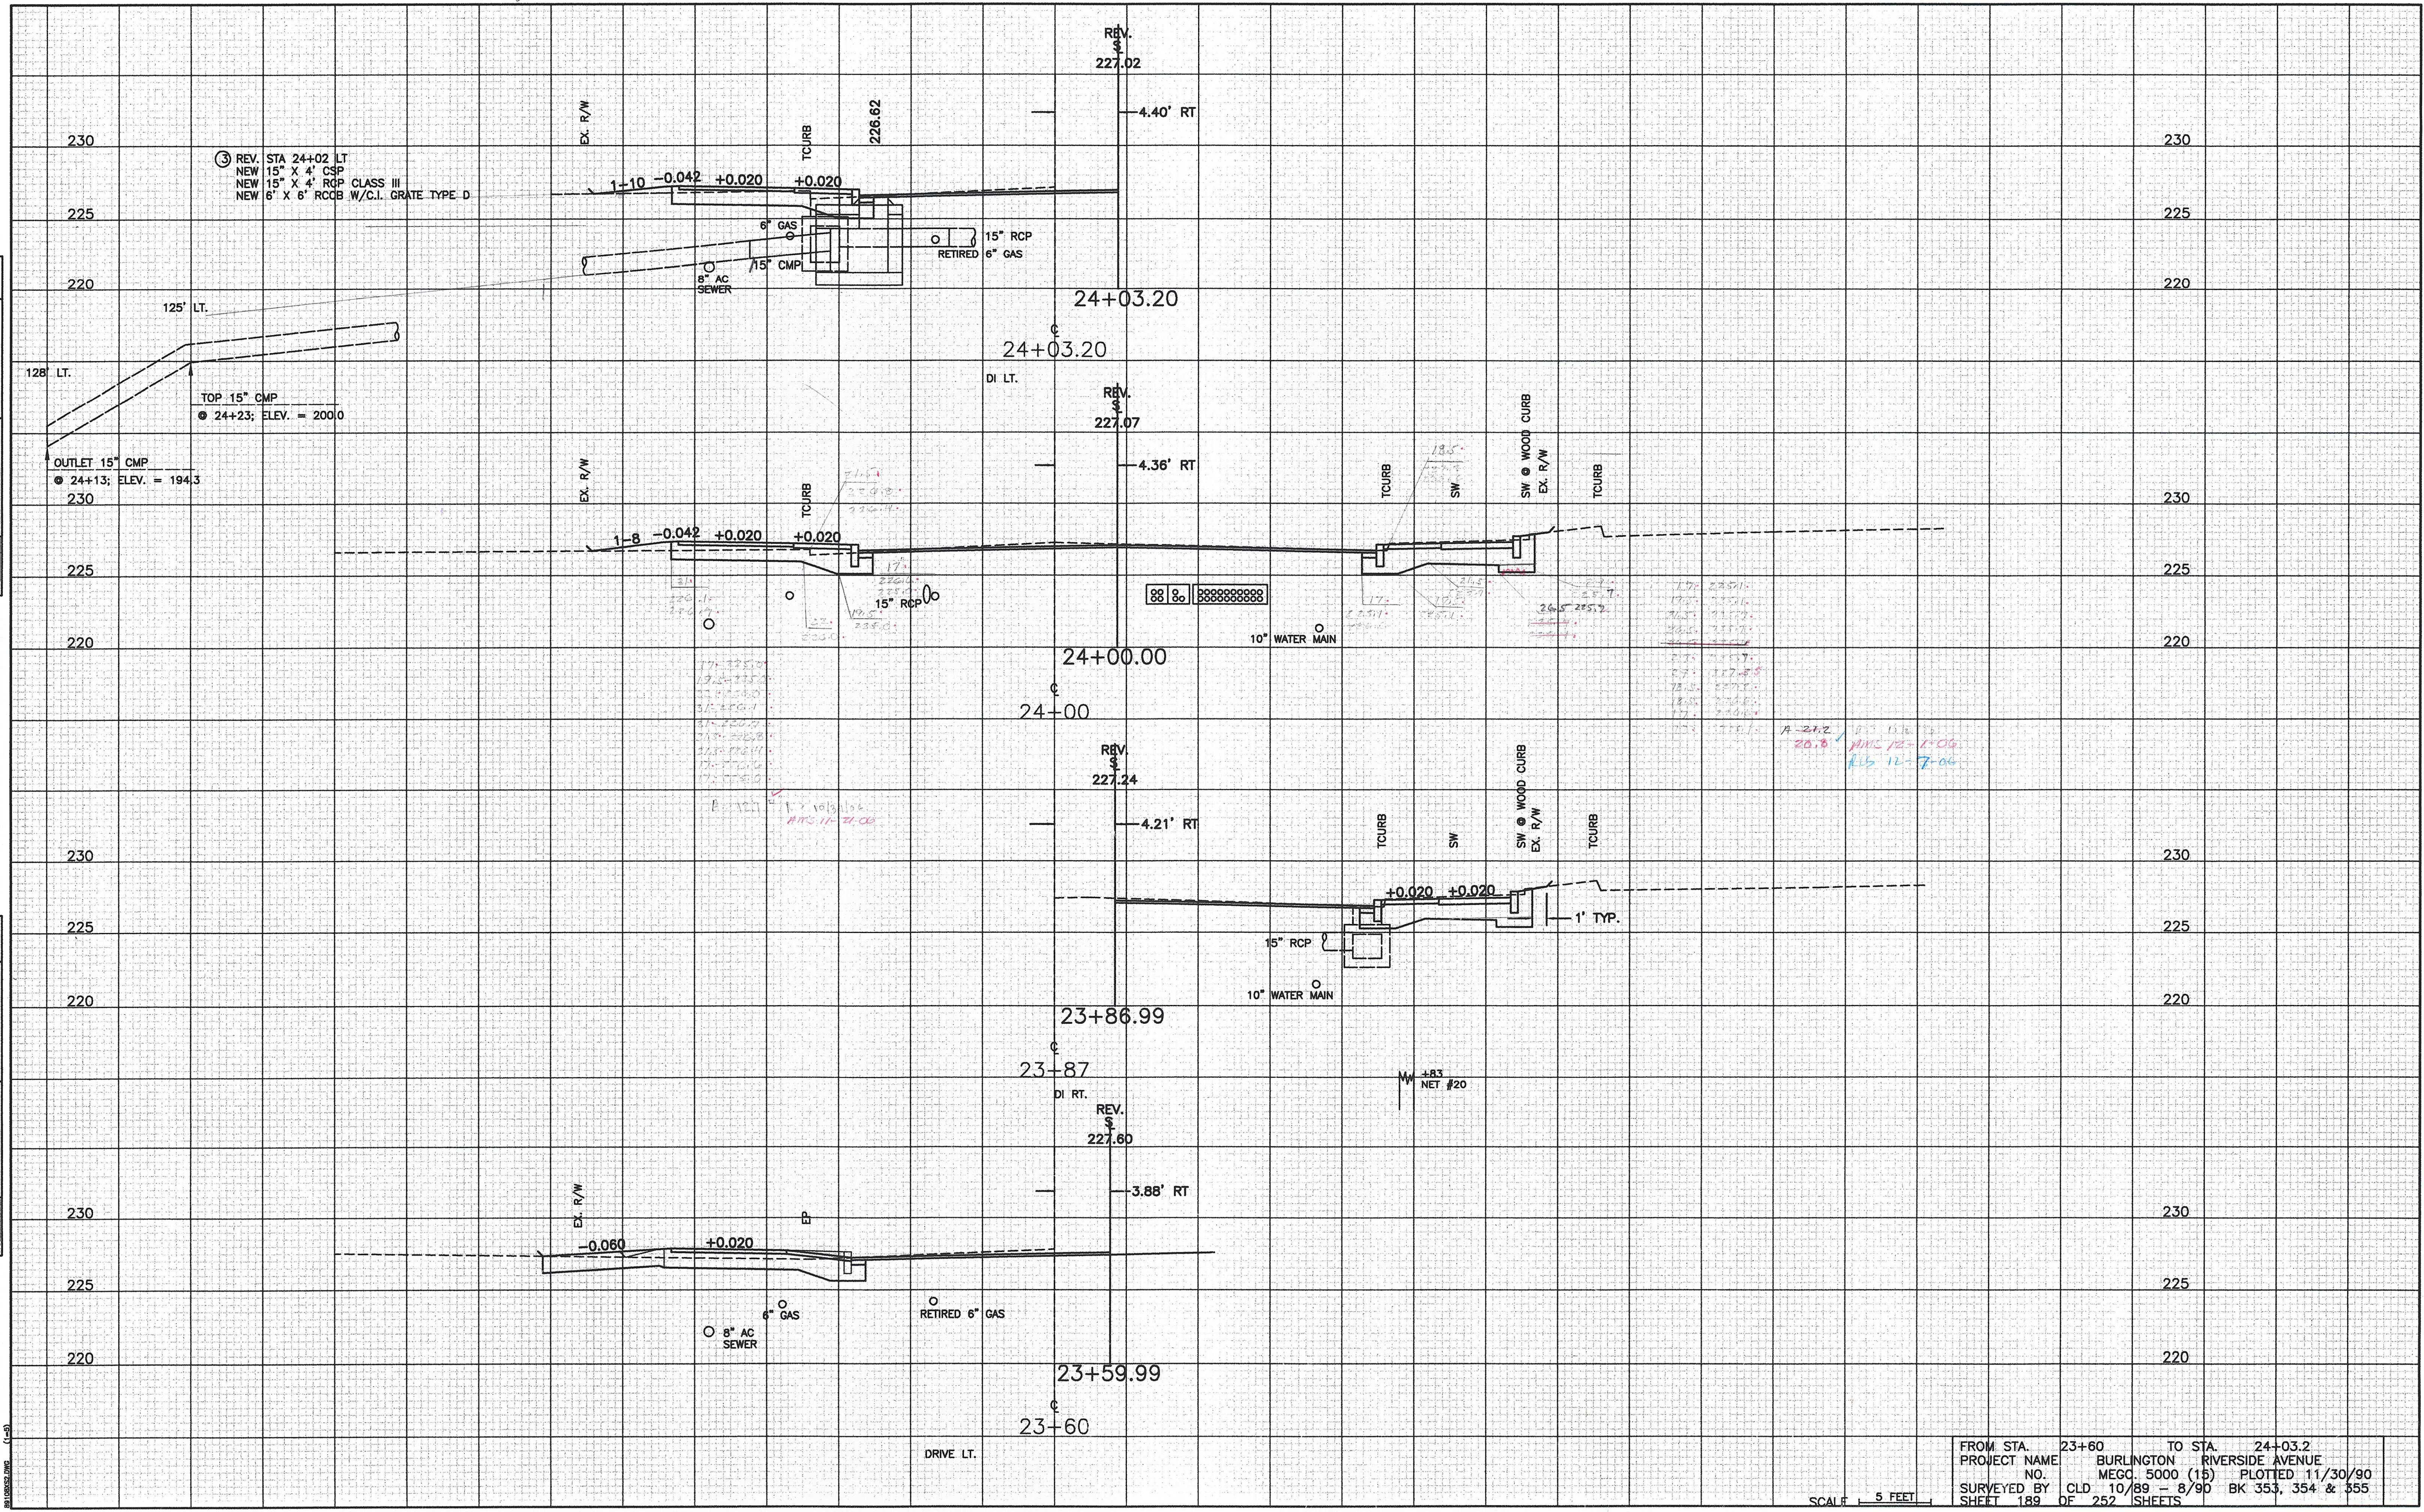

SCALE 5 FEET

FROM STA. 23+60 TO STA. 24+03.2
PROJECT NAME BURLINGTON RIVERSIDE AVENUE
NO. MEGC. 5000 (15) PLOTTED 11/30/90
SURVEYED BY CLD 10/89 - 8/90 BK 353, 354 & 355
SHEET 189 OF 252 SHEETS

PL 189 (1-9)