


DATE	
BY	
FINAL SURVEY	
SURVEYED	
TEMPLATE	
AREAS	
AREAS CHECKED	
NO	

DATE	
BY	
ORIGINAL SURVEY	
SURVEYED	
TEMPLATE	
AREAS	
AREAS CHECKED	
NO	

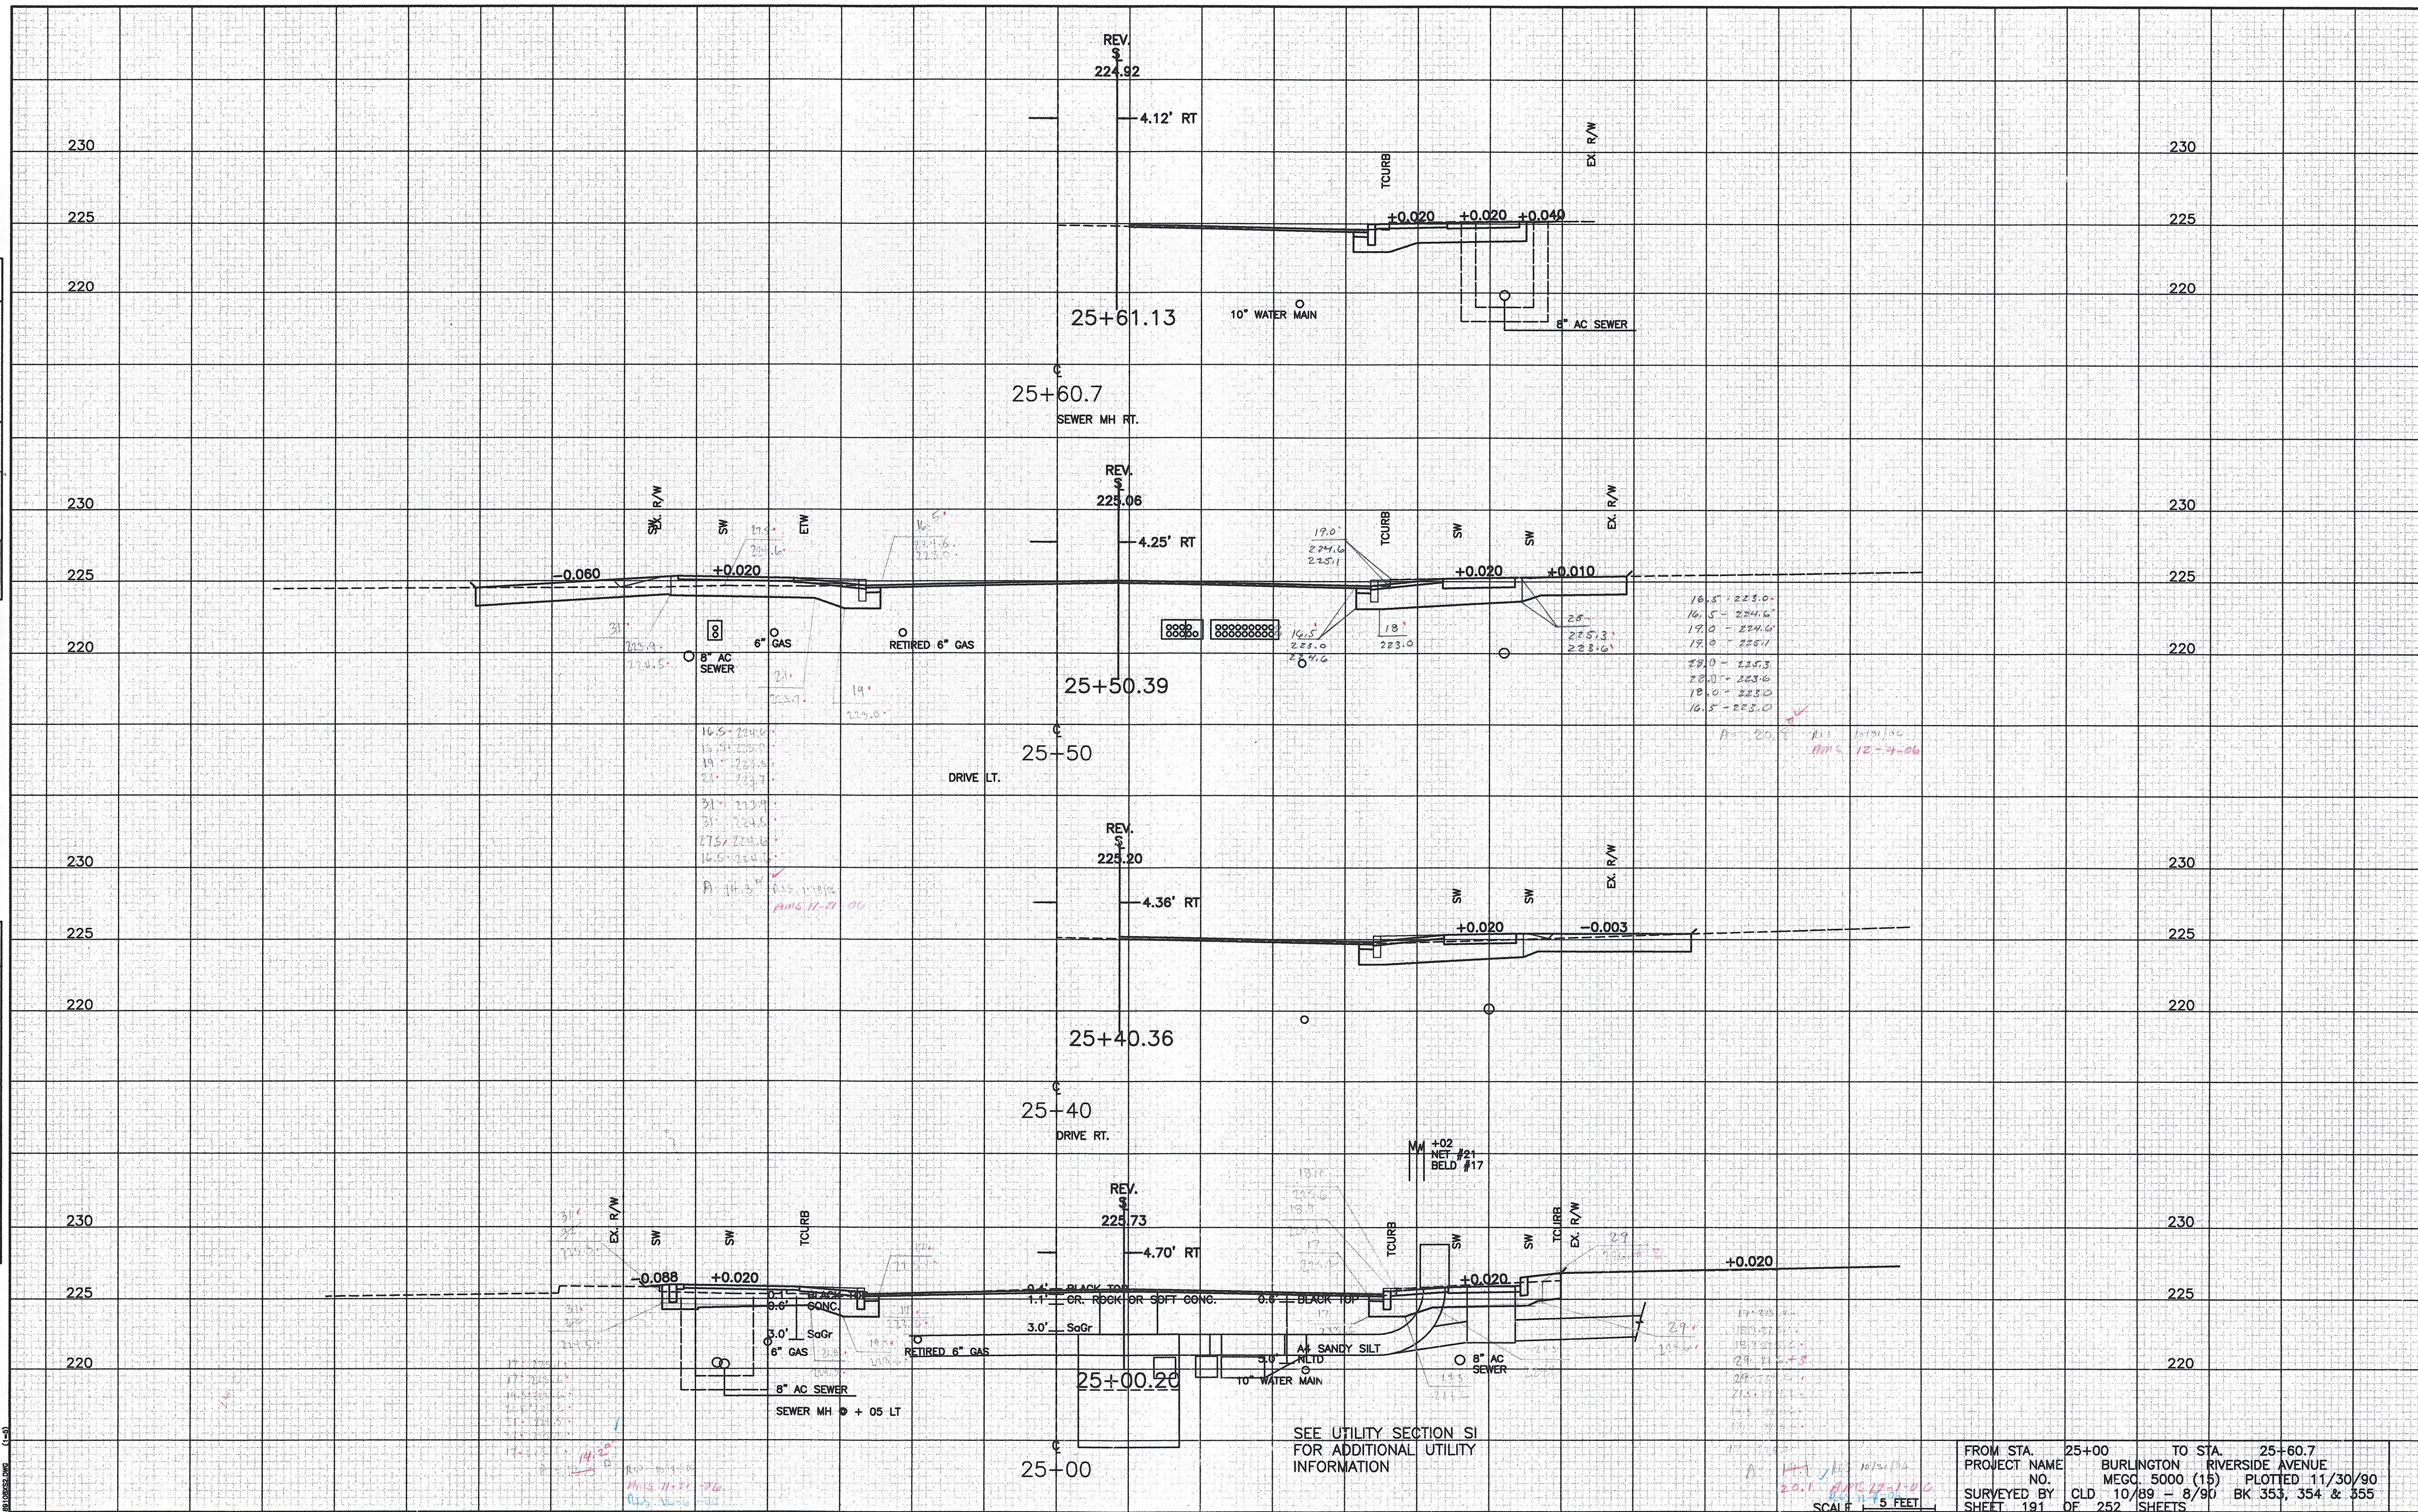

16.5 - 225.0
16.5 - 224.6
19.0 - 224.6
19.0 - 225.1
28.0 - 225.3
28.0 - 225.6
18.0 - 225.0
16.5 - 225.0

12.4 - 225.0
12.4 - 224.6
12.4 - 225.1
12.4 - 225.3
12.4 - 225.6
12.4 - 225.0
12.4 - 225.0

FROM STA. 25+00 TO STA. 25+60.7  
 PROJECT NAME BURLINGTON RIVERSIDE AVENUE  
 NO. MECC. 5000 (15) PLOTTED 11/30/90  
 SURVEYED BY CLD 10/89 = 8/90 BK 353, 354 & 355  
 SHEET 191 OF 252 SHEETS

SCALE 1" = 5 FEET