


DATE	
BY	
FINAL SURVEY	
PLOTTED	
TEMPLATE	
NO. OF SHEETS	
NO.	
AREAS CHECKED	

DATE	
BY	
ORIGINAL SURVEY	
PLOTTED	
TEMPLATE	
NO. OF SHEETS	
NO.	
AREAS CHECKED	

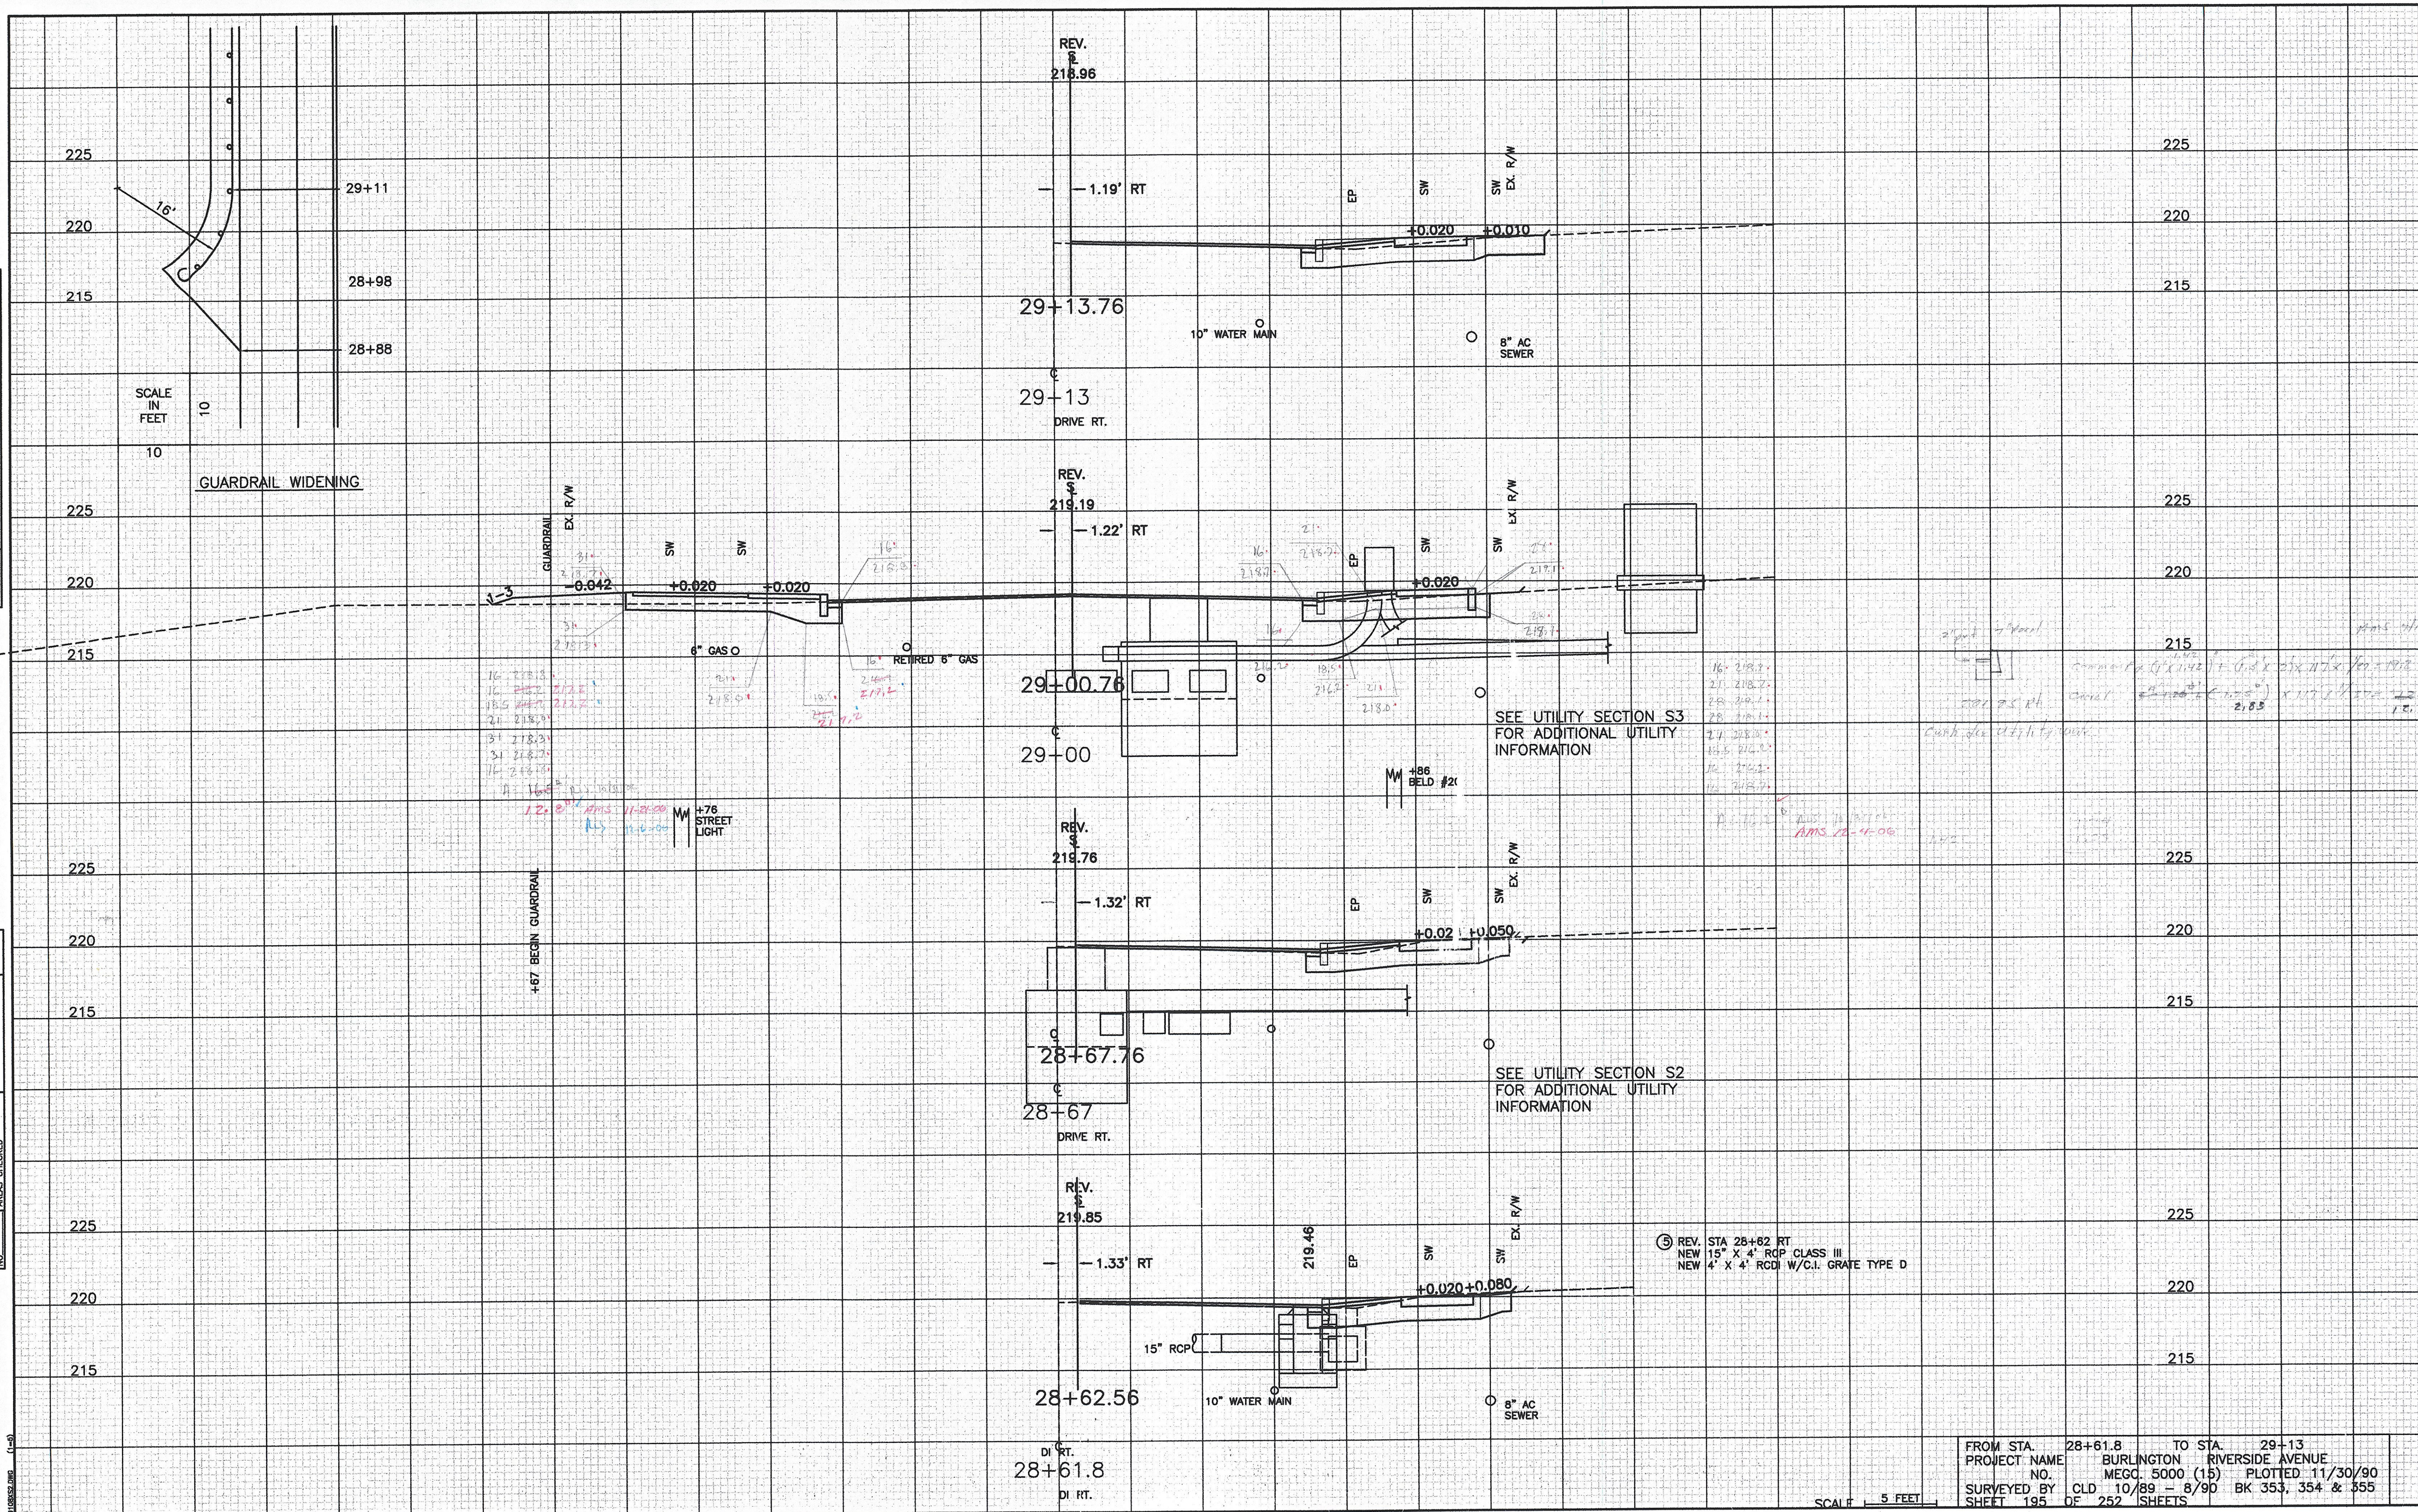

SCALE 1" = 5 FEET

FROM STA. 28+61.8 TO STA. 29+13
 PROJECT NAME BURLINGTON RIVERSIDE AVENUE
 NO. MEGC. 5000 (15) PLOTTED 11/30/90
 SURVEYED BY CLD 10/89 - 8/90 BK 353, 354 & 355
 SHEET 195 OF 252 SHEETS